


Sommer's 2nd Acre Tract
 Addition To Elgin, Oregon
 The NE 1/4 of SE 1/4 Sec. 16, T-1-N., R-39-E-W.M.

Scale 16" = 1 mile

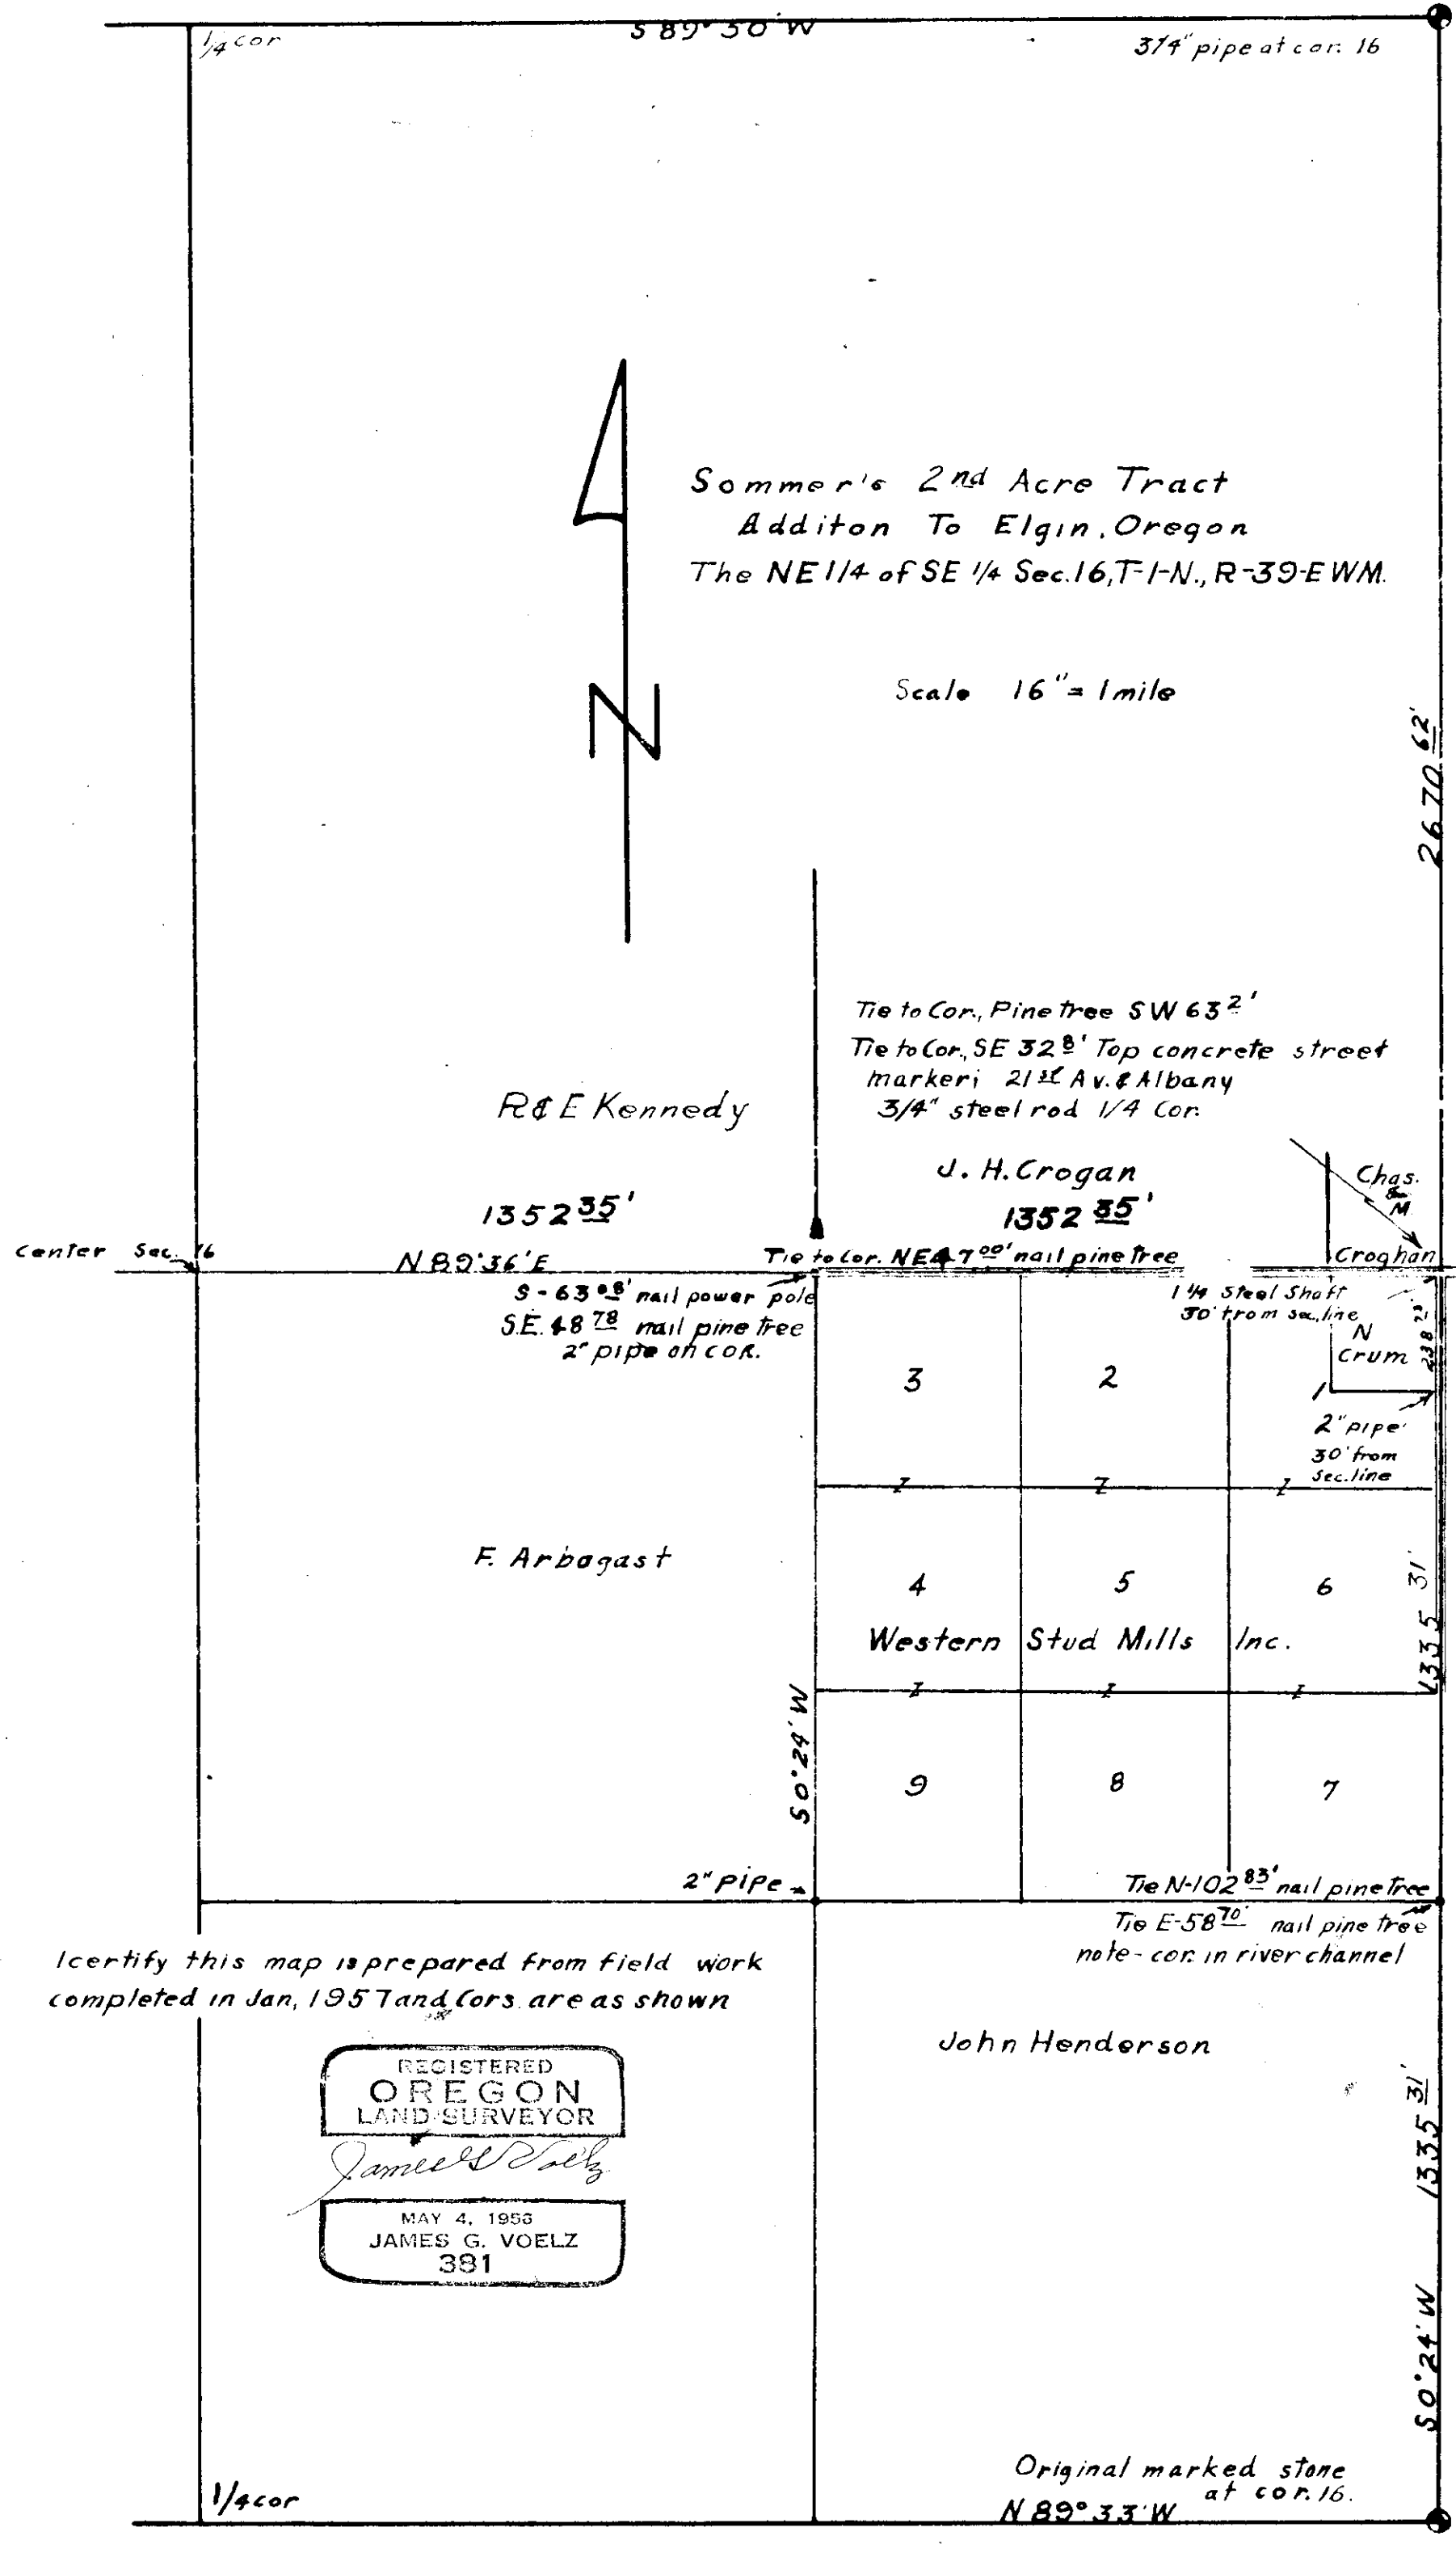

I certify this map is prepared from field work completed in Jan, 1957 and Cors. are as shown

REGISTERED
OREGON
 LAND SURVEYOR

James G. Voelz

MAY 4, 1956
 JAMES G. VOELZ
 391