


33
33
SHERIFF RICHARD A. JENSEN
OF
Washington, Union County Oregon

Union Corner

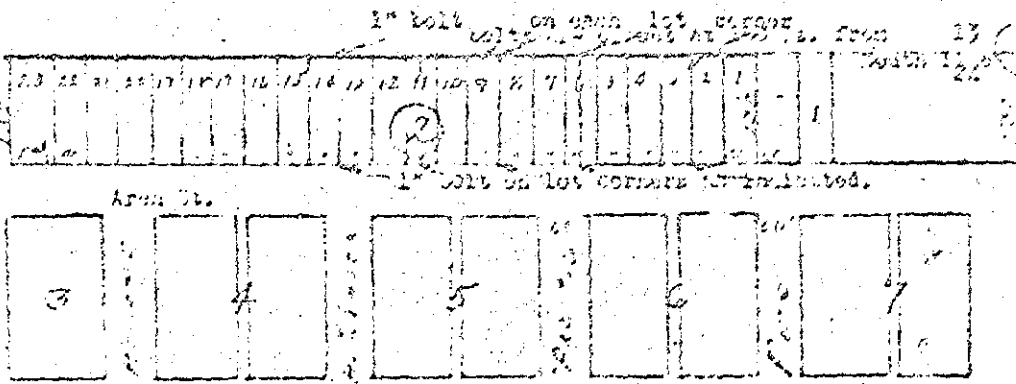

Survey of lots as shown on plat.
 Lots 1 and 2 to Davis C. Ford and Bertha E. Ford
 Deed book 110, page 379 dated Nov. 29, 1943.
 West half of lot 6 and all lots 7 and 8 to same
 parties (Ford) by deed book 101, page 83, Jan. 6, 1940.
 Home Valley Lumber Co;
 Lots 3-5 and 1/2 of lot 6
 Lots 12-13 and 1/2 of lot 11.
 All of lots 17 to 23 inclusive.
 Lots 9-10 and 1/2 lot 11 except north 1/4 ft. to
 Ethel Colez, by deed book 100 page 294 dated June 17, 1943
 Lots 14-15 and 16 to Fletcher Oil Company. by deed book
 101, page 290 dated April 19, 1940.

This survey is correct as shown by me in July 1959

REGISTERED
 OREGON
 LAND SURVEYOR
James G. Voelz
 MAY 4, 1959
 JAMES G. VOELZ
 234

