

34

SURVEY


BE OR

LOTS 1-2-7-8, BLOCK 17, ORIGINAL UNION  
UNION, OREGON.


FOR

MYRTLE CLINE & WALTER J. WALDIE

JULY 31, 1953.

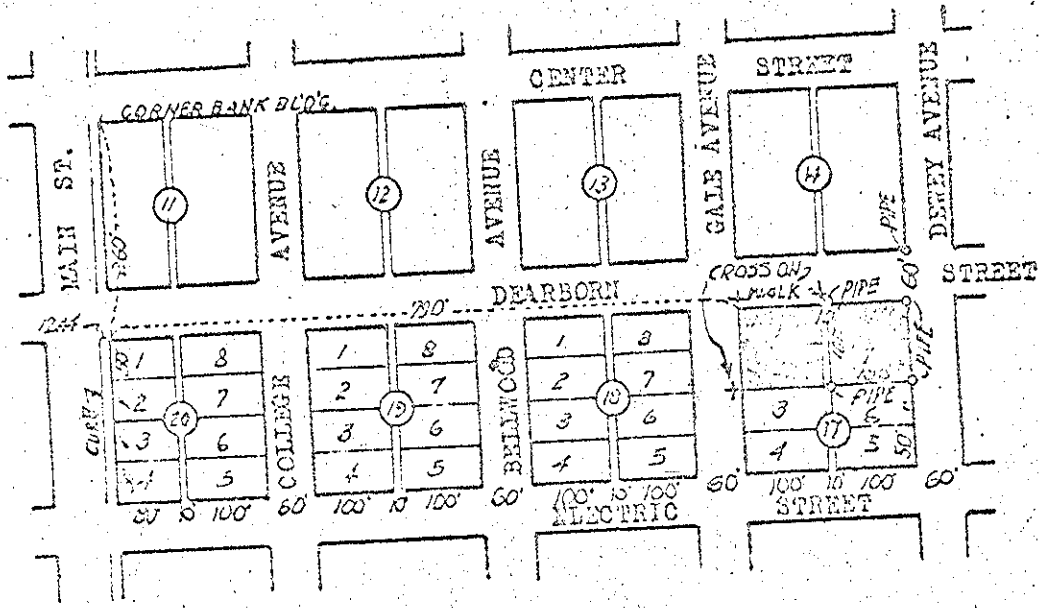

SCALE 1"=200'

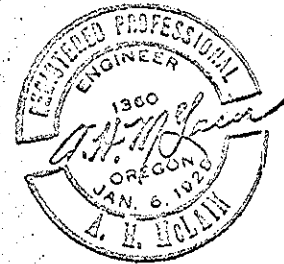

34