
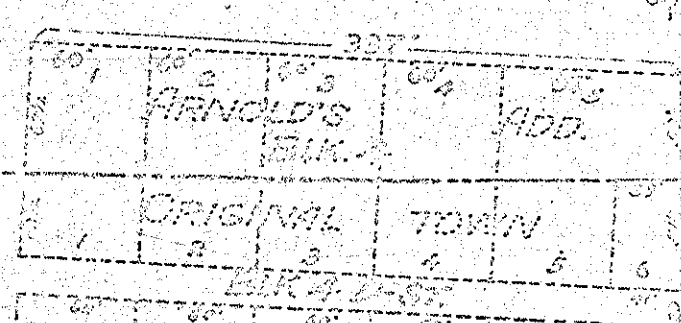
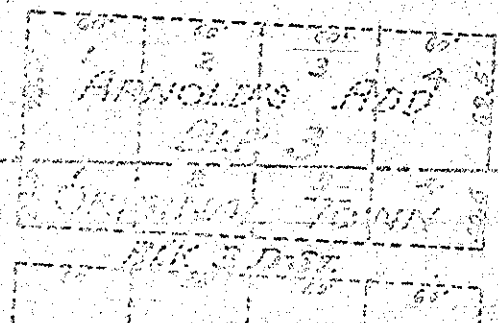


*See Book
change*

N

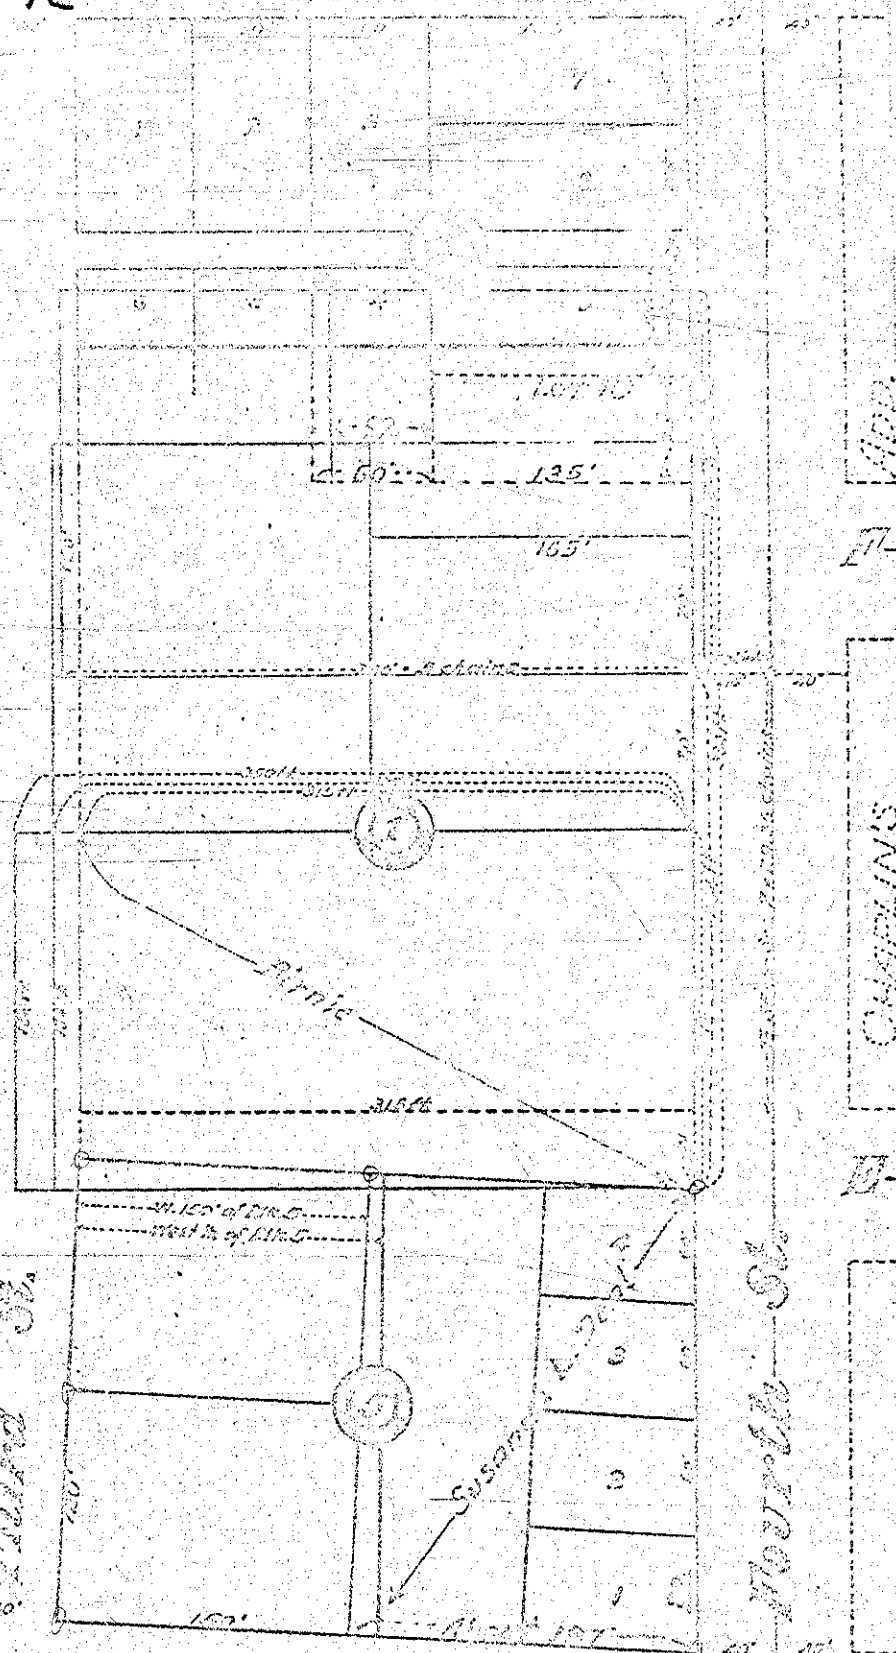

ADD.

17

CHAMPLIN'S

11

W. St.

W. St.