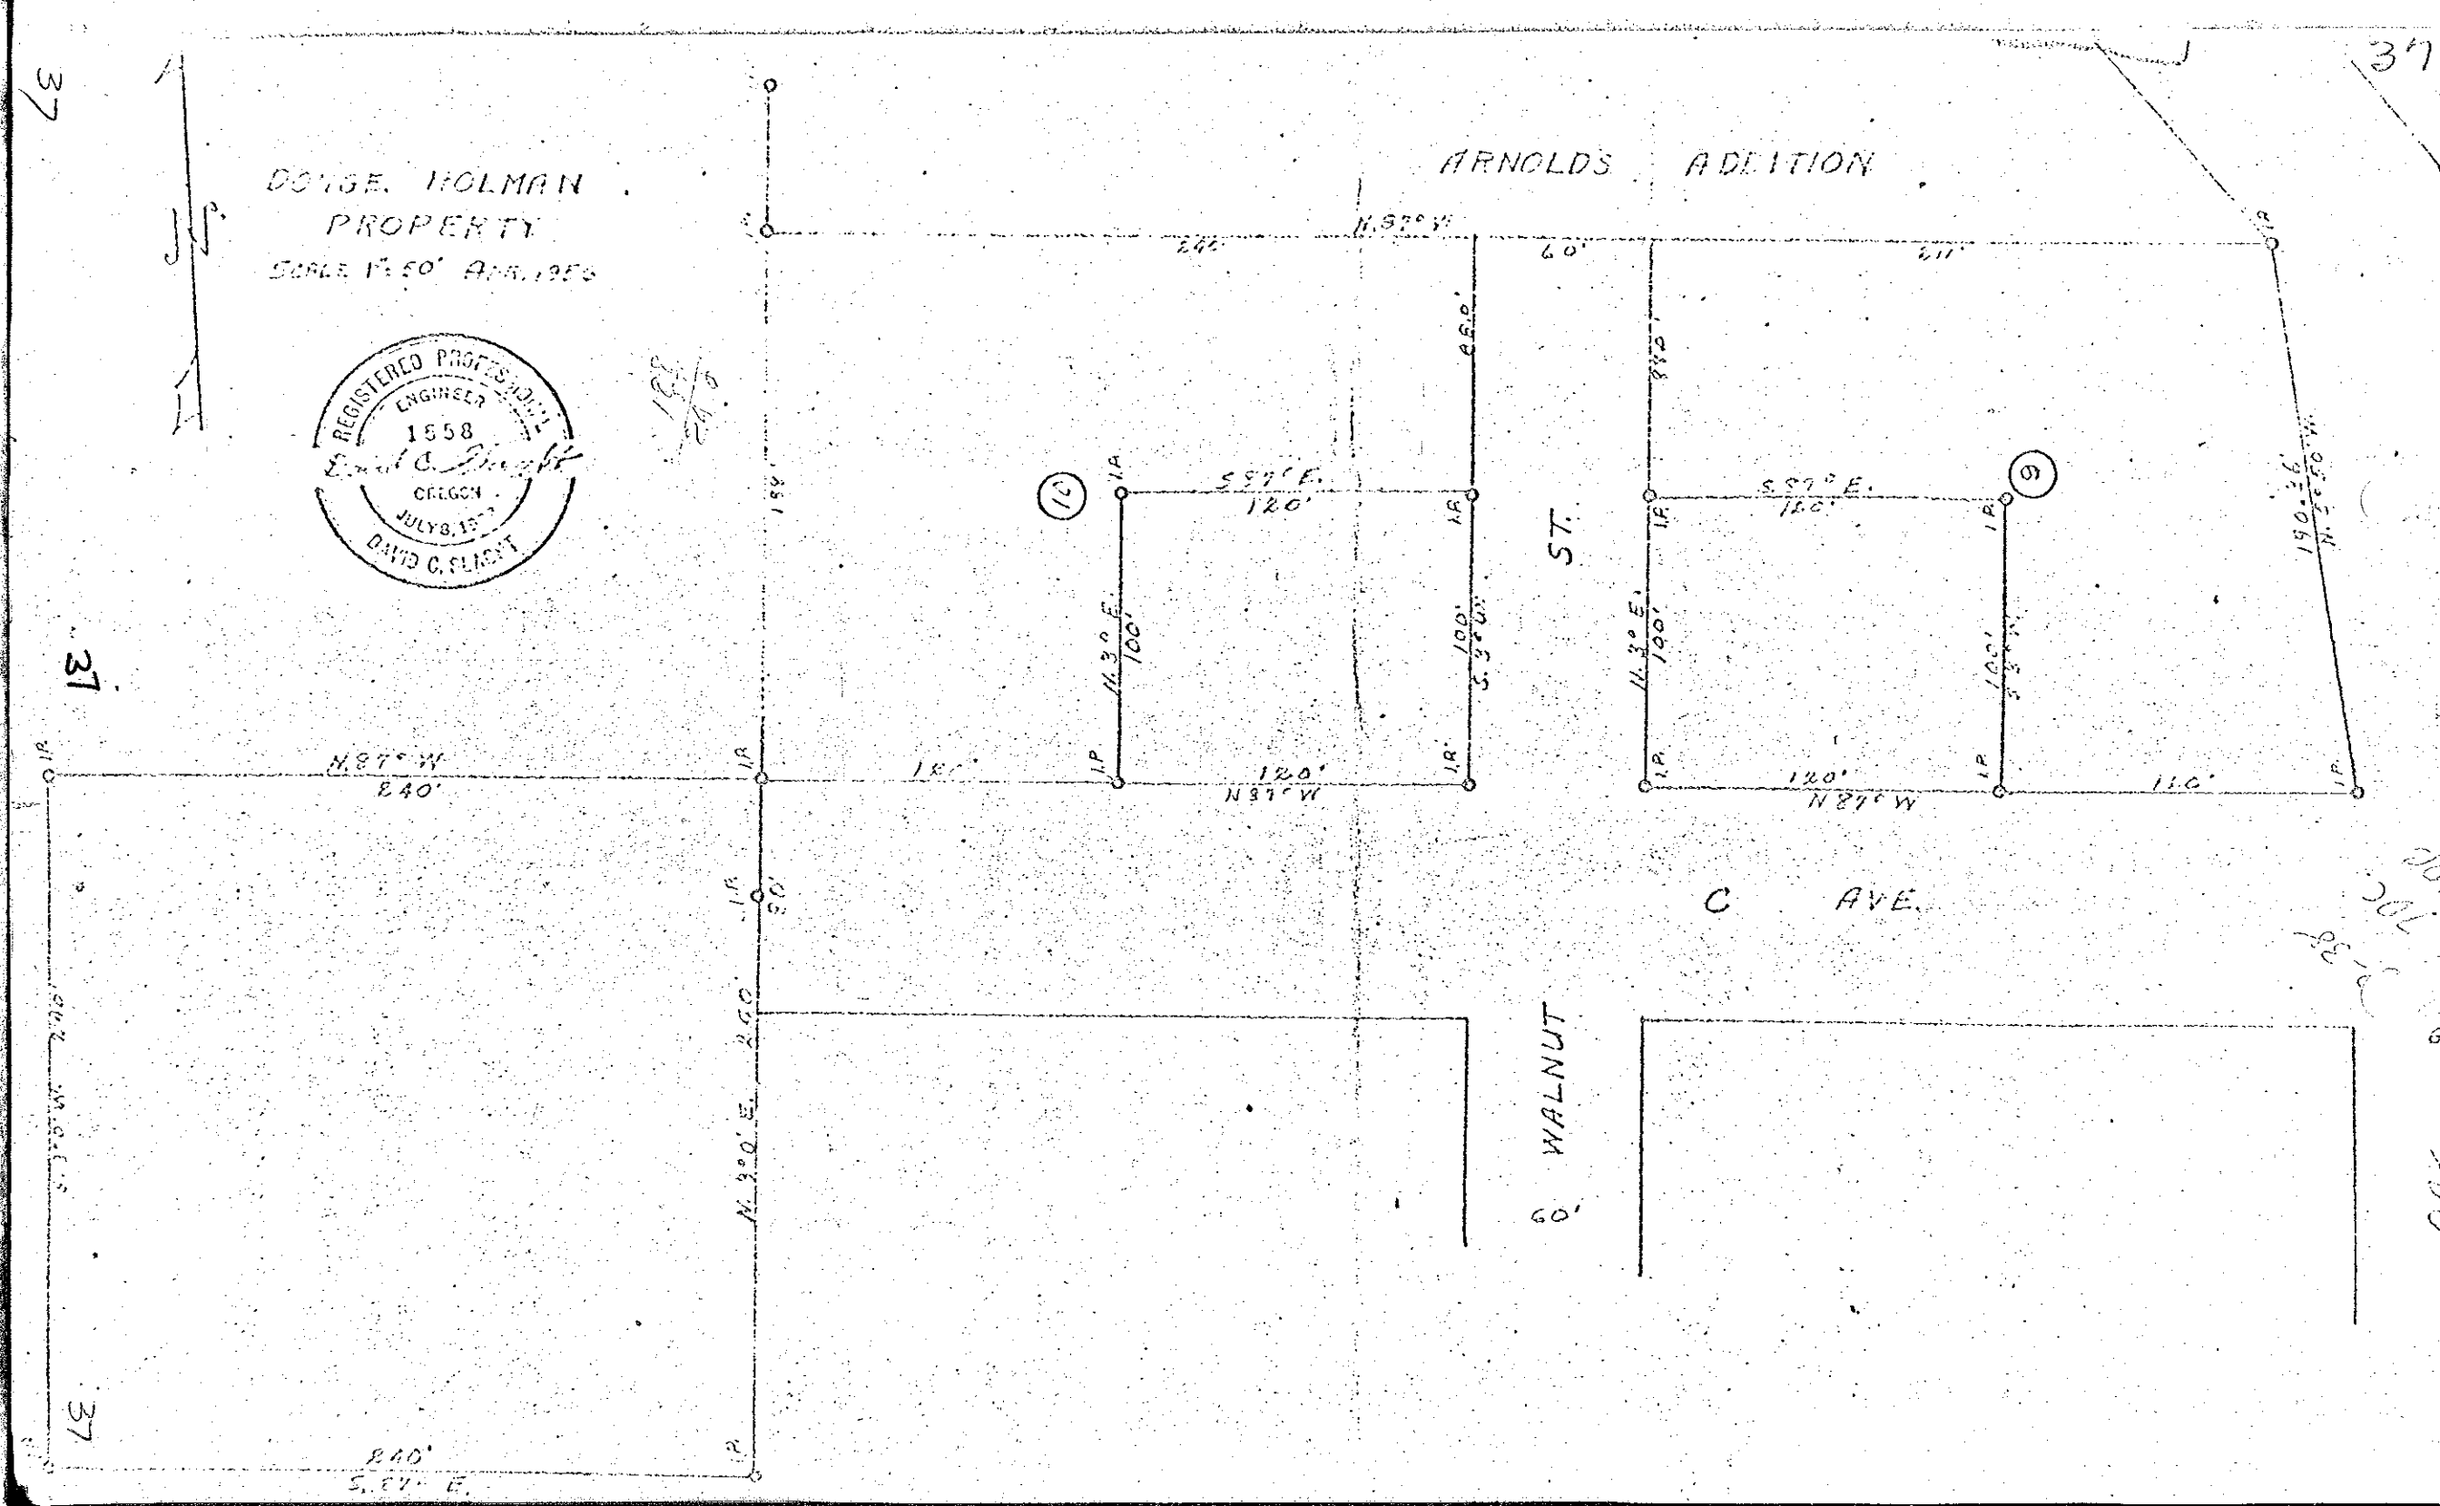
DOUGE. HOLMAN
PROPERTY
SCALE 1" = 50' APR. 1956
REGISTERED PROFESSIONAL ENGINEER
1558
OREGON
JULY 8, 1957
DAVID C. SLIGHT
ARNOLDS ADDITION
N.87° W.
240'
60'
211'
S.87° E.
120'
N.3° E.
100'
S.3° E.
N.87° W
ST.
C AVE.
WALNUT
60'
N.3° E.
260'
S.87° E.
37