


29
39

SURVEY
OF

6E

39

LINE BETWEEN LOTS 3 - 4, BLOCK 5,
ARNOLD & DRY'S ADDITION
LA GRANDE, OREGON.
9-17-49

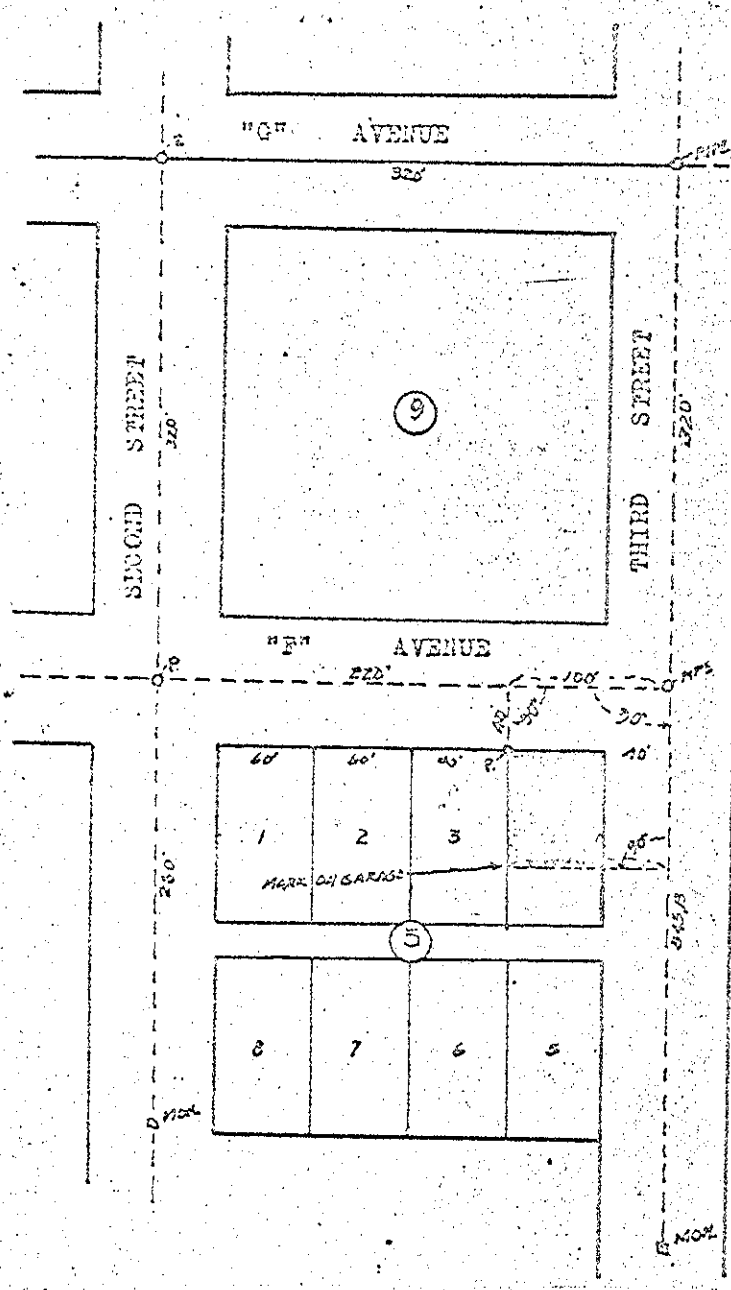

SCALE 1"=100'

