SURVEY

OF

LOT 5, BLOCK 1, CARP'S SUBDIVISION
HONAN'S ADDITION
LA GRANDE, OREGON
9-10-65
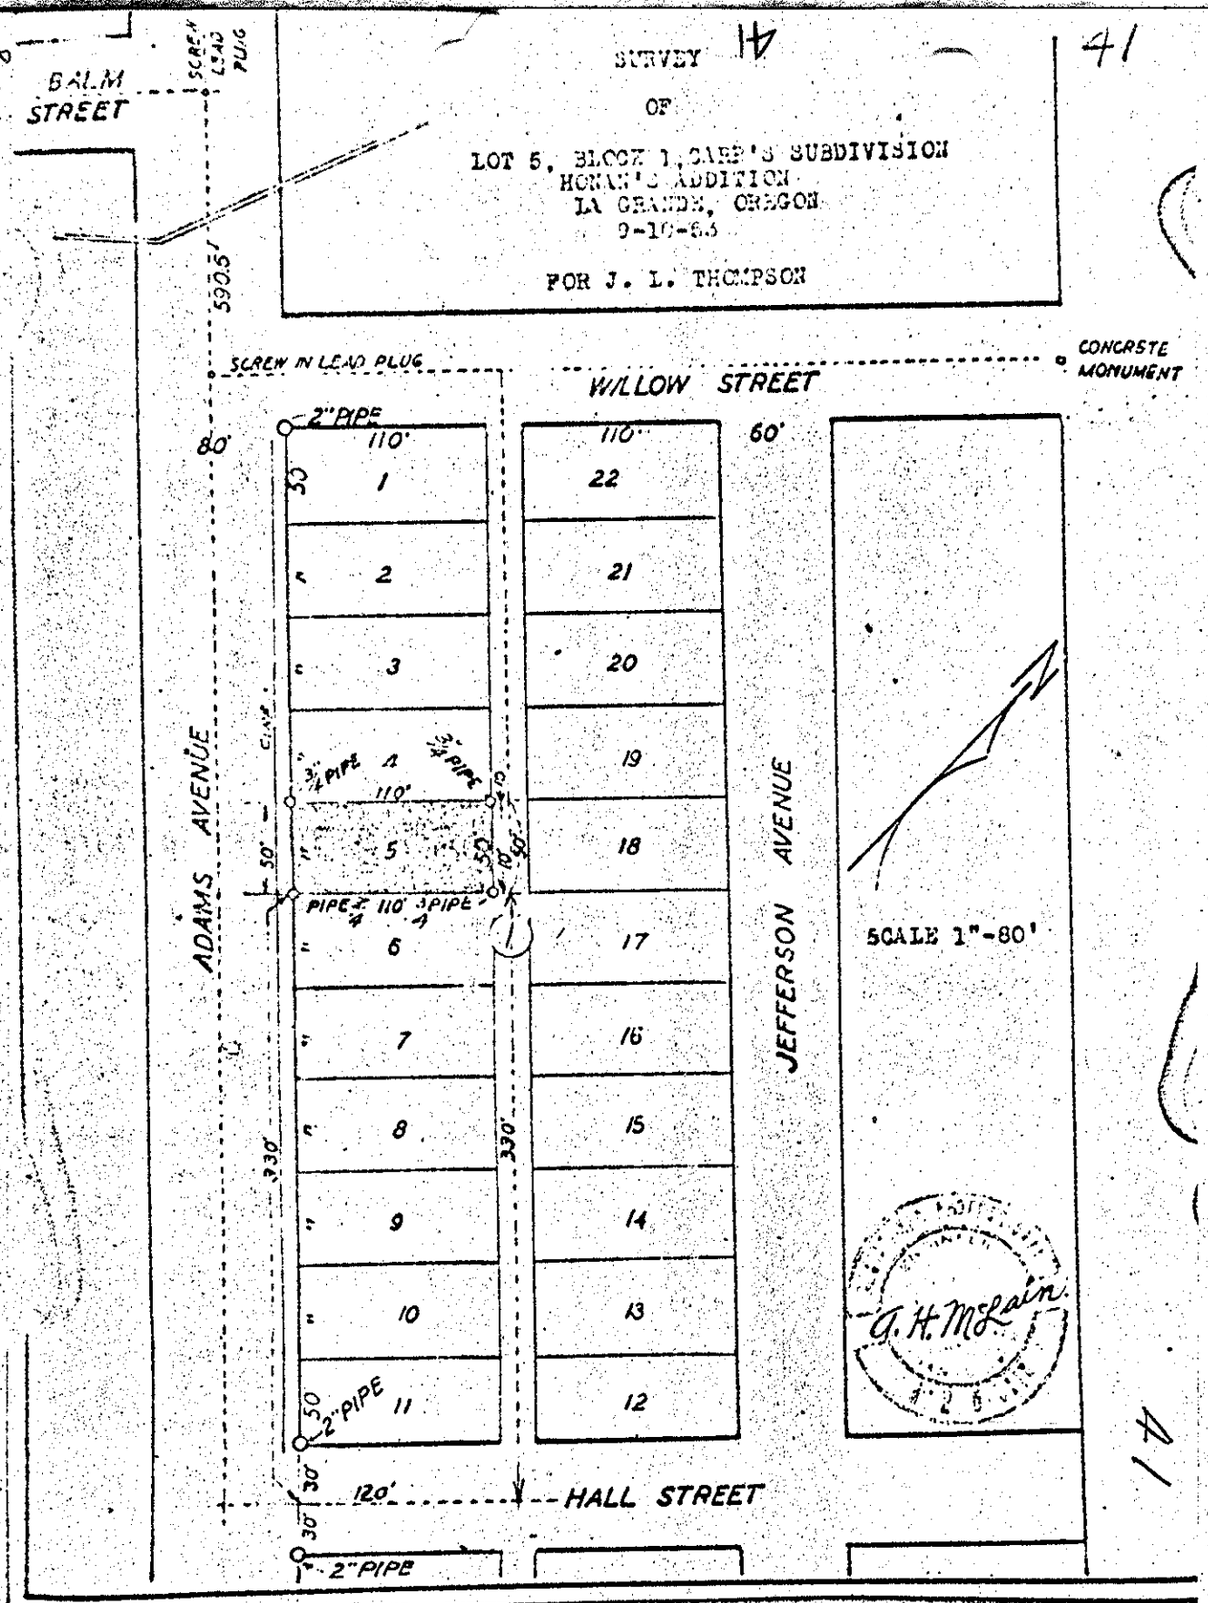
FOR J. L. THOMPSON