


42
24

42

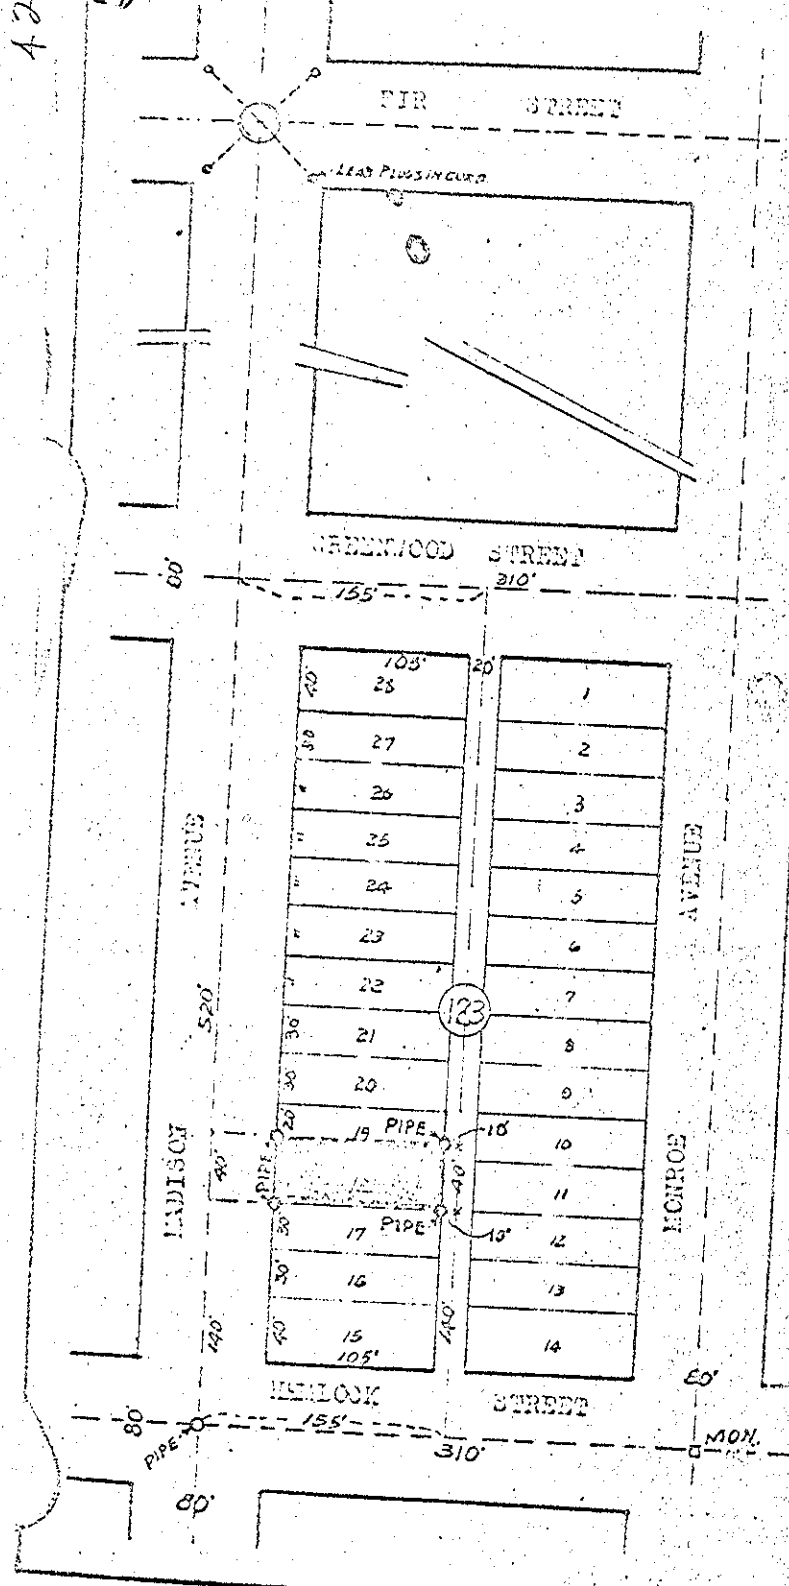

3 38 500 4900

SURVEY
 OF
 LOT 18 & SE 10' LOT 19, BLOCK 123,
 CHAPLIN'S ADDITION TO LA GRANDE,
 OREGON. OCTOBER 29, 1943.

SCALE 1"=100'

