

43

43

43

PIR STREET

GREENWOOD STREET

STREET


MADISON AVENUE

HEMLOCK STREET

MONROE AVENUE

UNION PACIFIC RAILROAD

RIGHT OF WAY

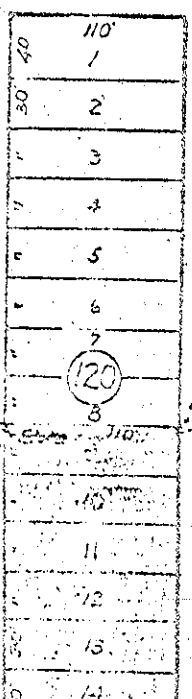

SURVEY

OF

24
LOTS 9-10-11-12-13-33 Block 120
Chaplin's Addition To La Grande, Ore.

Nov. 4, 1949.

3 38 500 6200

SCALE 1"=100'

