

44

44


44

SURVEY

DP

LOTS 7 & 8, BLOCK 18, CHAPLIN'S ADDITION  
LA GRANDE, OREGON.

FOR LEE McLAUGHLIN  
8-8-54.

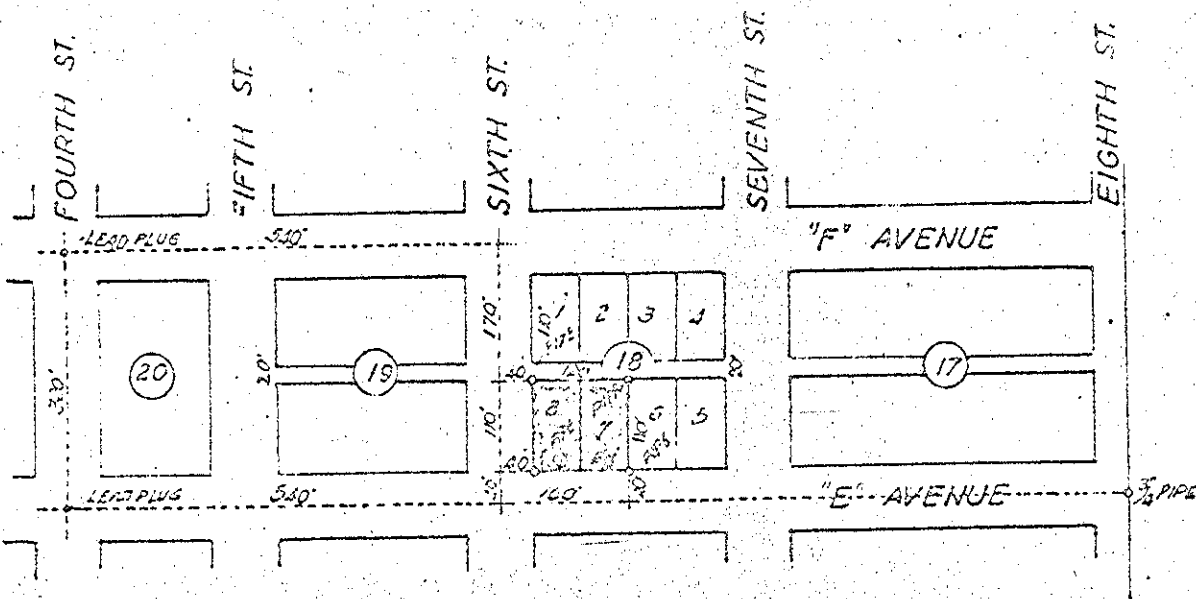

SCALE 1"=200'

