


50

50

50

Chaplin's

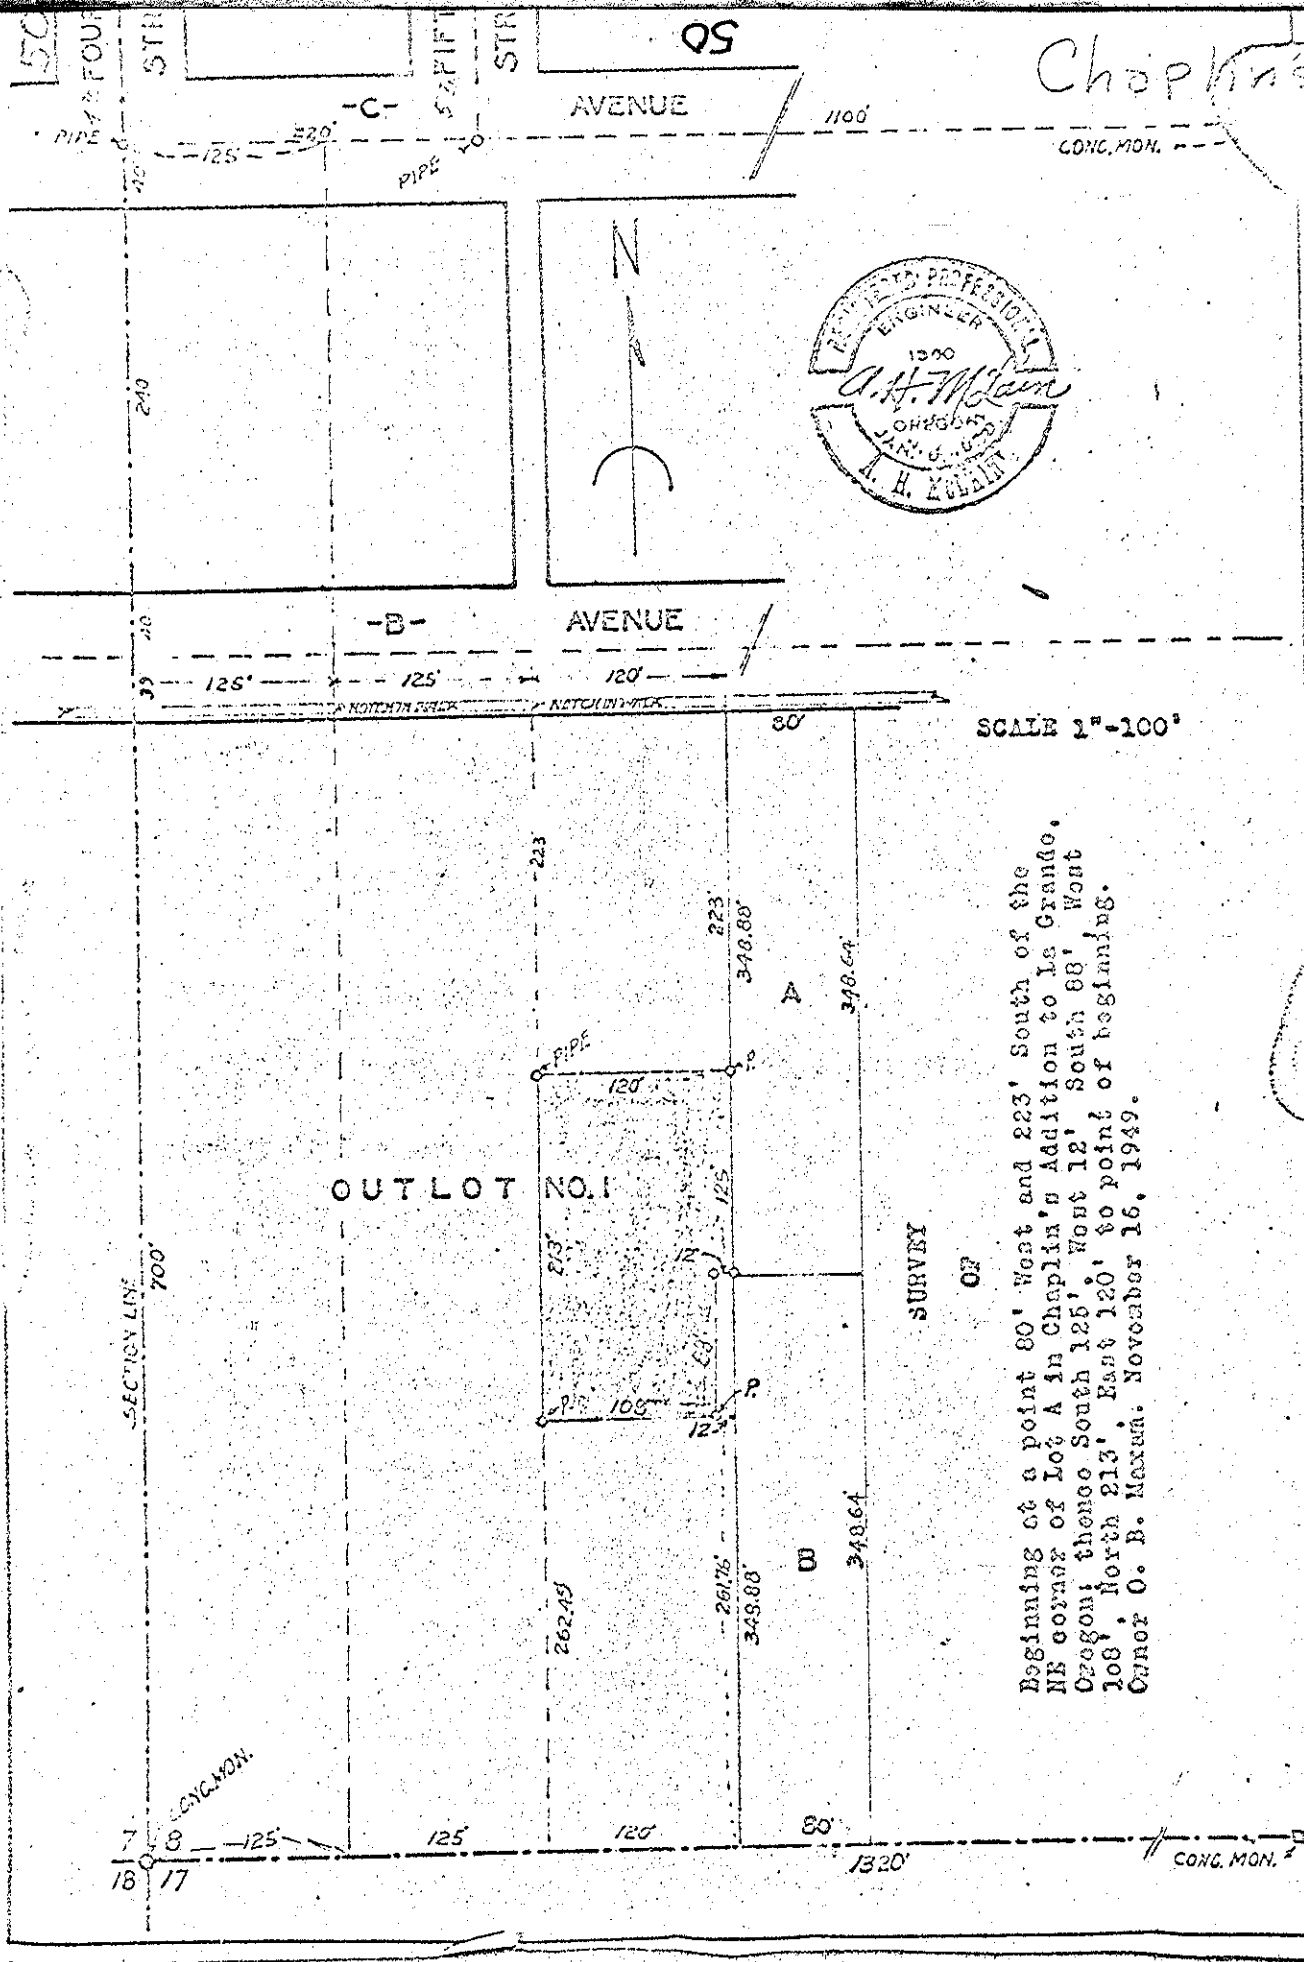

SCALE 1"=100'

OUTLOT NO. 1

SURVEY OF

Beginning at a point 80' West and 223' South of the NE corner of Lot A in Chaplin's Addition to La Grande, Oregon; thence South 125' West 12' South 68' West 108' North 213' East 120' to point of beginning. Cuneo O. B. Maxam. November 16, 1919.

7  
18  
8  
17  
CONG. MON.

1320  
CONG. MON.