


51
5
51

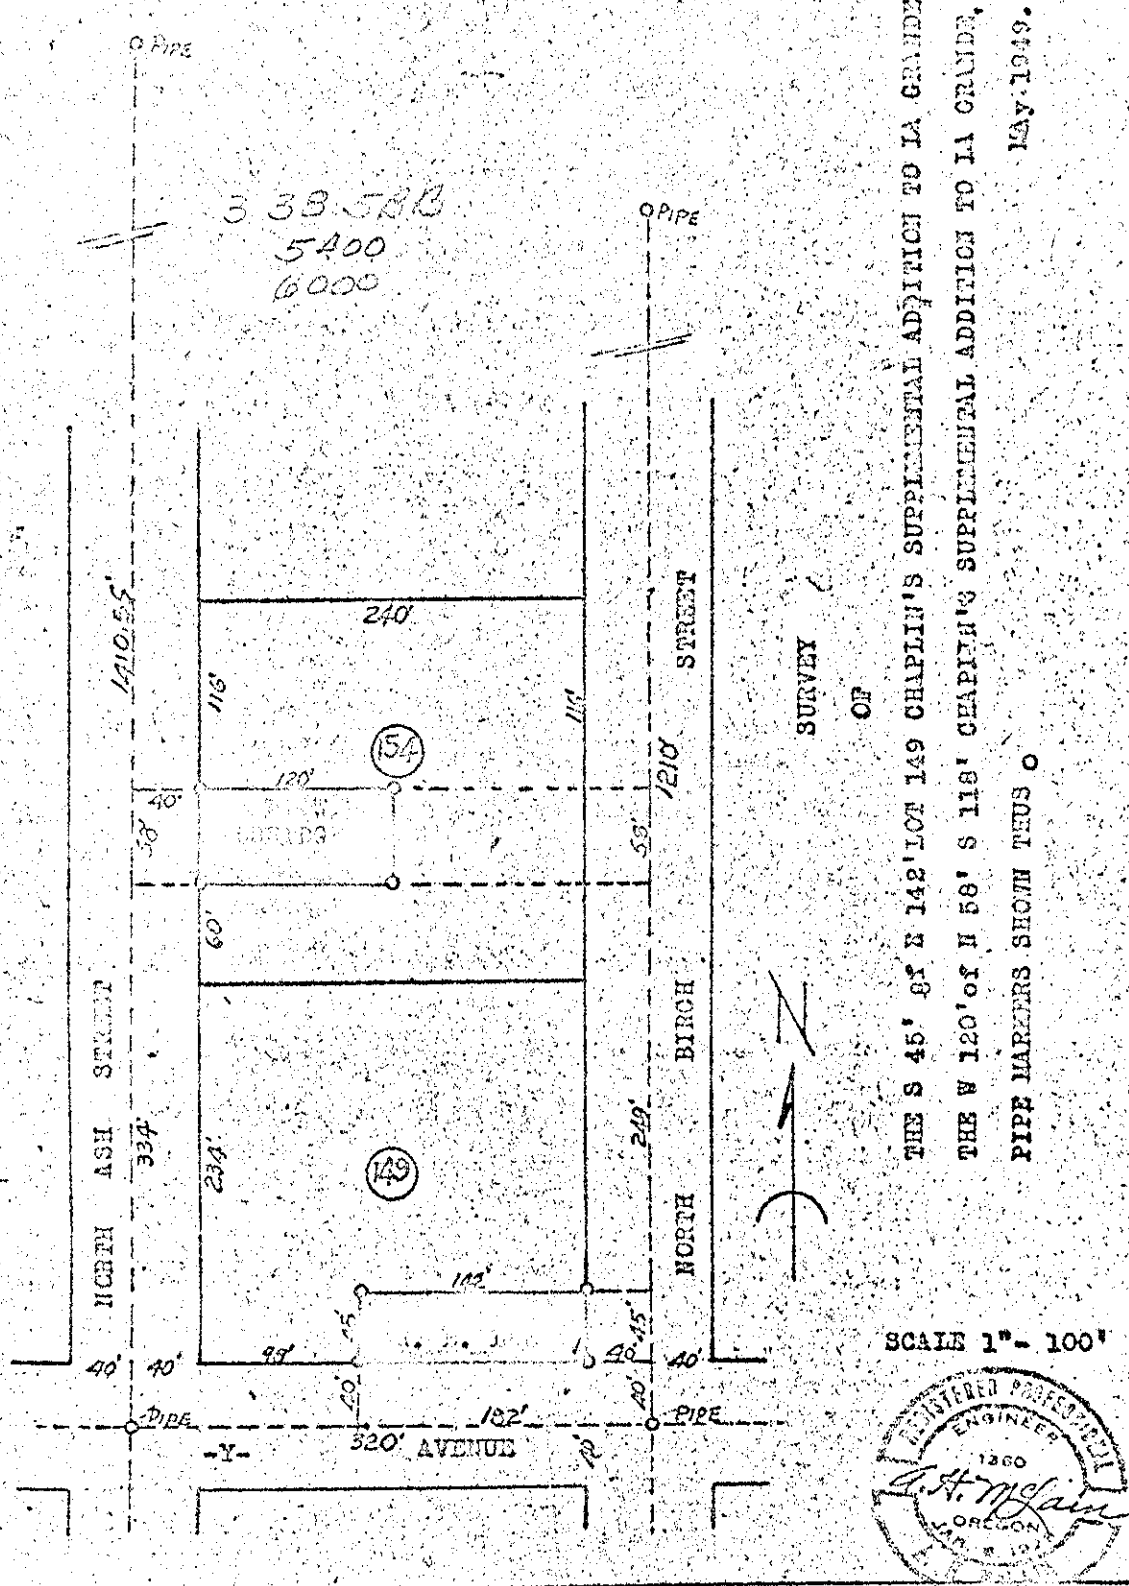

333.58B
5400
6000

THE S 45' OF E 142' LOT 149 CHAPLIN'S SUPPLEMENTAL ADDITION TO LA GRANDE, OREGON
THE W 120' OF N 58' S 118' CHAPLIN'S SUPPLEMENTAL ADDITION TO LA GRANDE, OREGON
PIPE MARKERS SHOWN THUS O
MAY 1919.

Chapl.

4thave

SURVEY OF

SCALE 1" = 100'



5/16