

53


53

WASHINGTON AVENUE

LEAD PLUG

202.7

LEAD PLUG

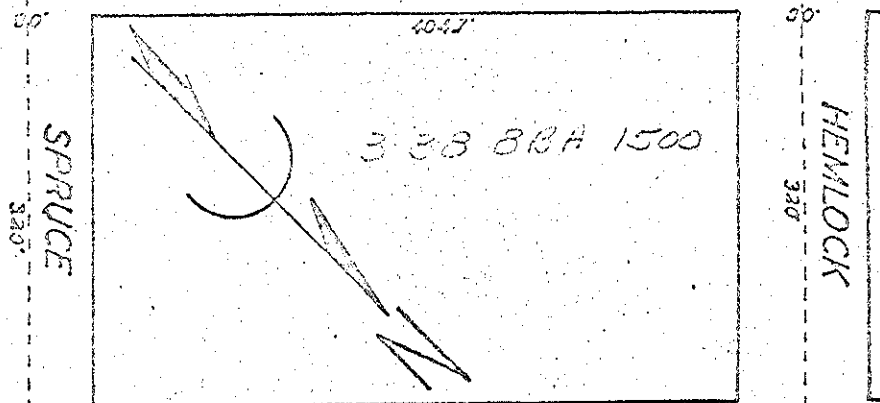


SPRUCE STREET

HEMLOCK STREET

ADAMS AVENUE

LEAD PLUG

484.7

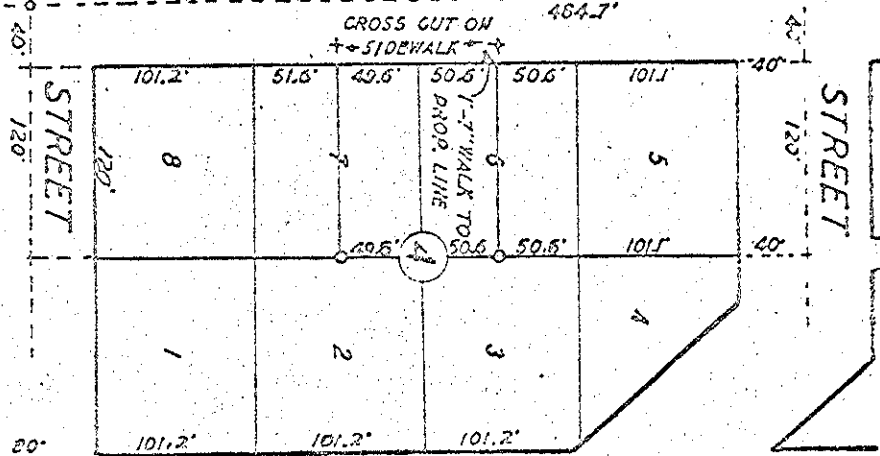

SPRUCE STREET

HEMLOCK STREET

JEFFERSON AVENUE

SURVEY

FOR Wm. BOHNEKAMP

I, A.H. McLain of La Grande, Oregon, hereby certify that I made a survey of The northwesterly 49.6 feet of lot numbered (7) and the southeasterly 50.6 feet of lot numbered six (6), all in block numbered four (4) of Coggan's Addition to La Grande, Union County, Oregon, on January 10, 1953, and that said survey is correct.

*A.H. McLain*



SCALE 1" = 100'

53