


54-54

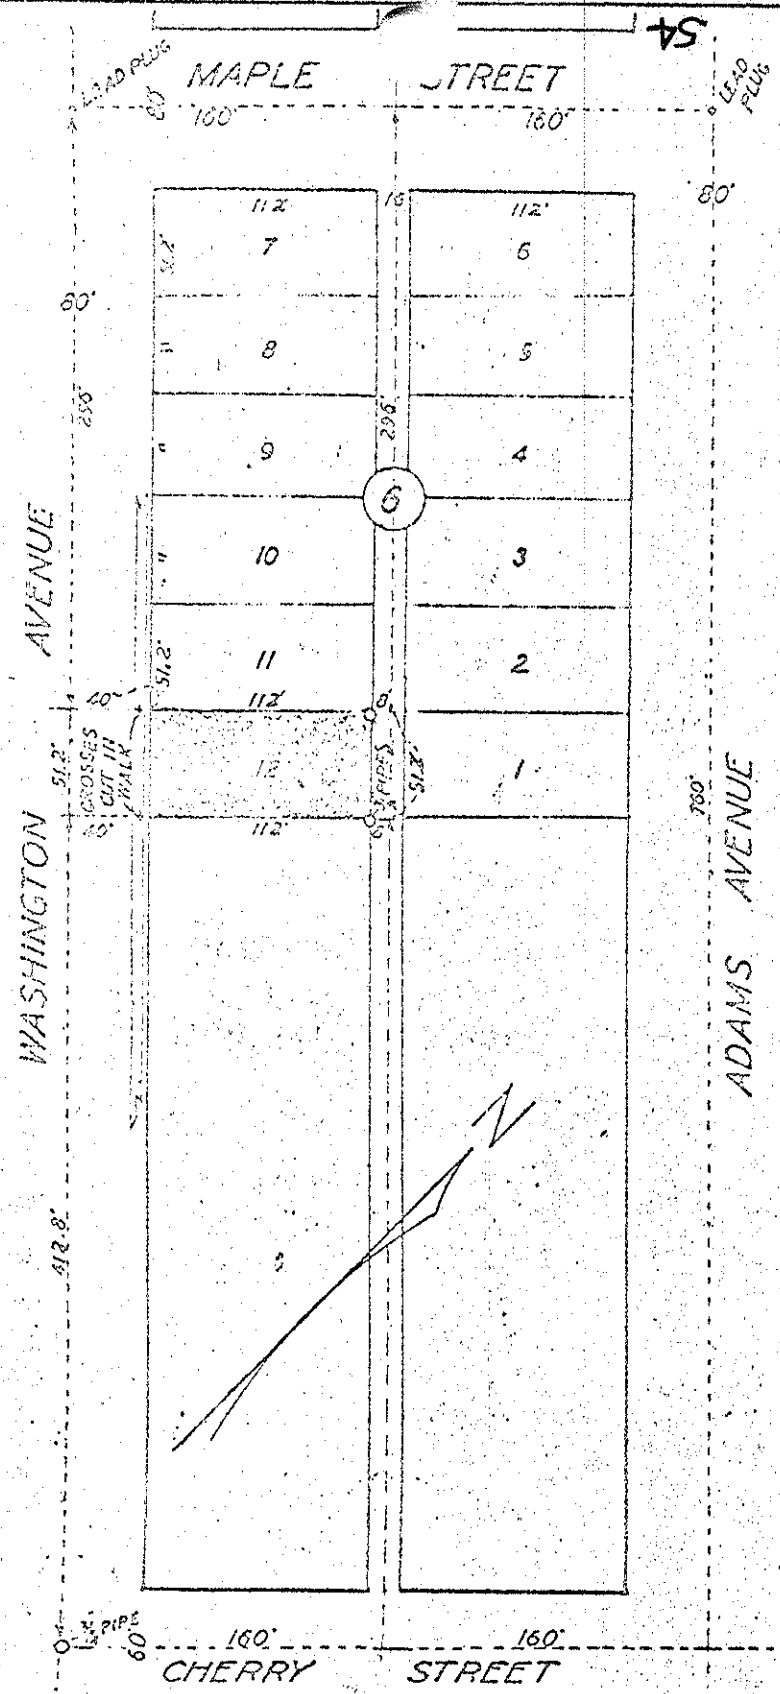

SCALE 1"=80'

SURVEY OF
 LOT 12, WARREN'S SUBDIVISION OF
 BLOCK 6, COGGAN'S 1ST & 2ND ADDITION TO
 LA GRANDE, OREGON.
 FOR D.F. SCHRIVER
 6-17-54