


57

MAUDE JOHNSON

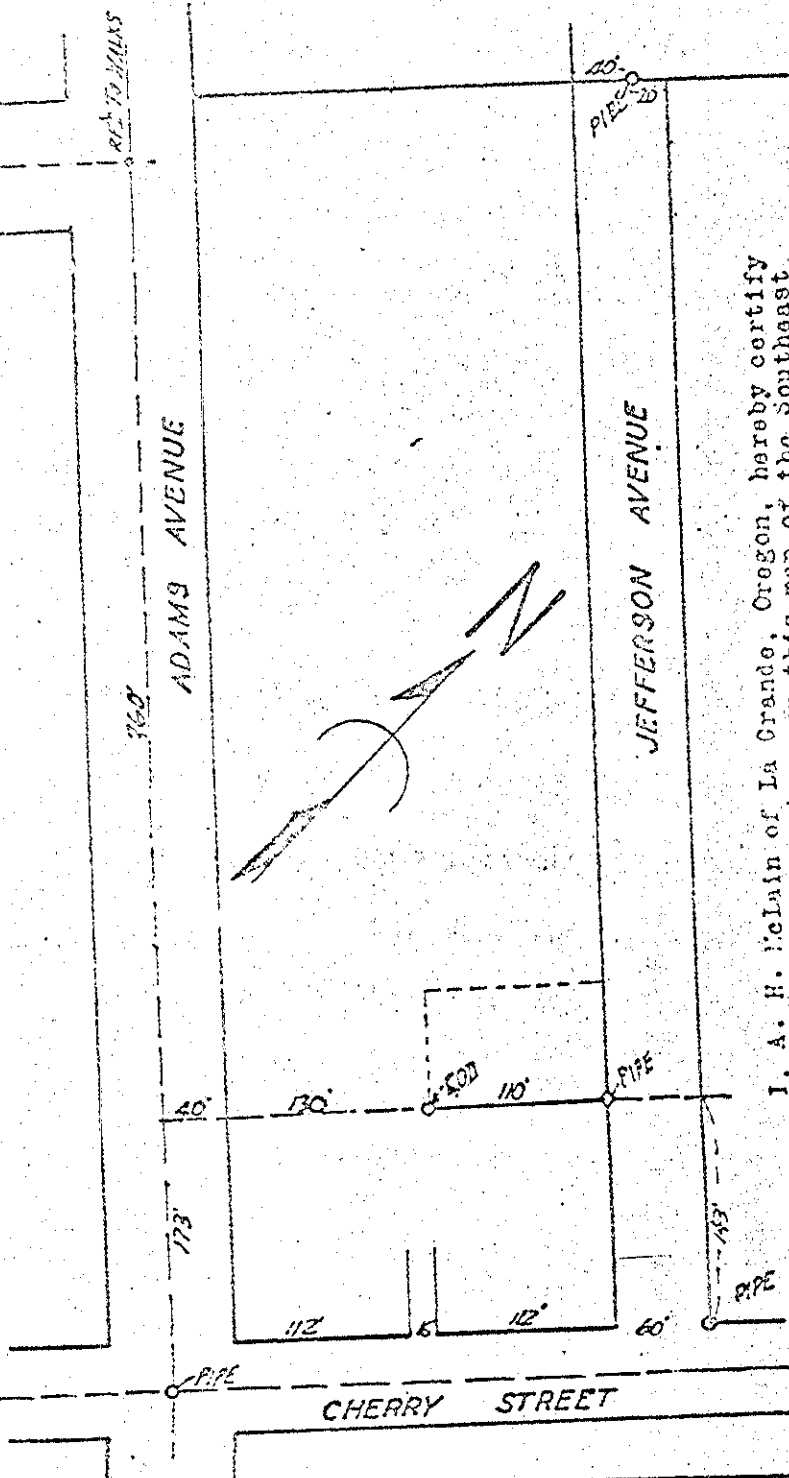

I, A. H. McLain of La Grande, Oregon, hereby certify that I made a survey as shown on this map, of the Southeast line of the following described property-Beginning 130 feet Northeast and 3 feet Northwest of the Southeast corner of Tract No. 10000, Corbett's 2nd Addition to La Grande, Oregon; thence Northeast 110 feet to Jefferson Avenue; thence Northwest 75 feet; thence Southwest 110 feet; thence Southeast 75 feet to beginning. Date of survey May 4, 1953.
 Scale 1" = 100'

A. H. McLain

