


OF
LOT 14, BLOCK 2, CONNOR'S ADDITION
TO LA GRANDE, OREGON
8-21-54
FOR W. M. WISSE

59

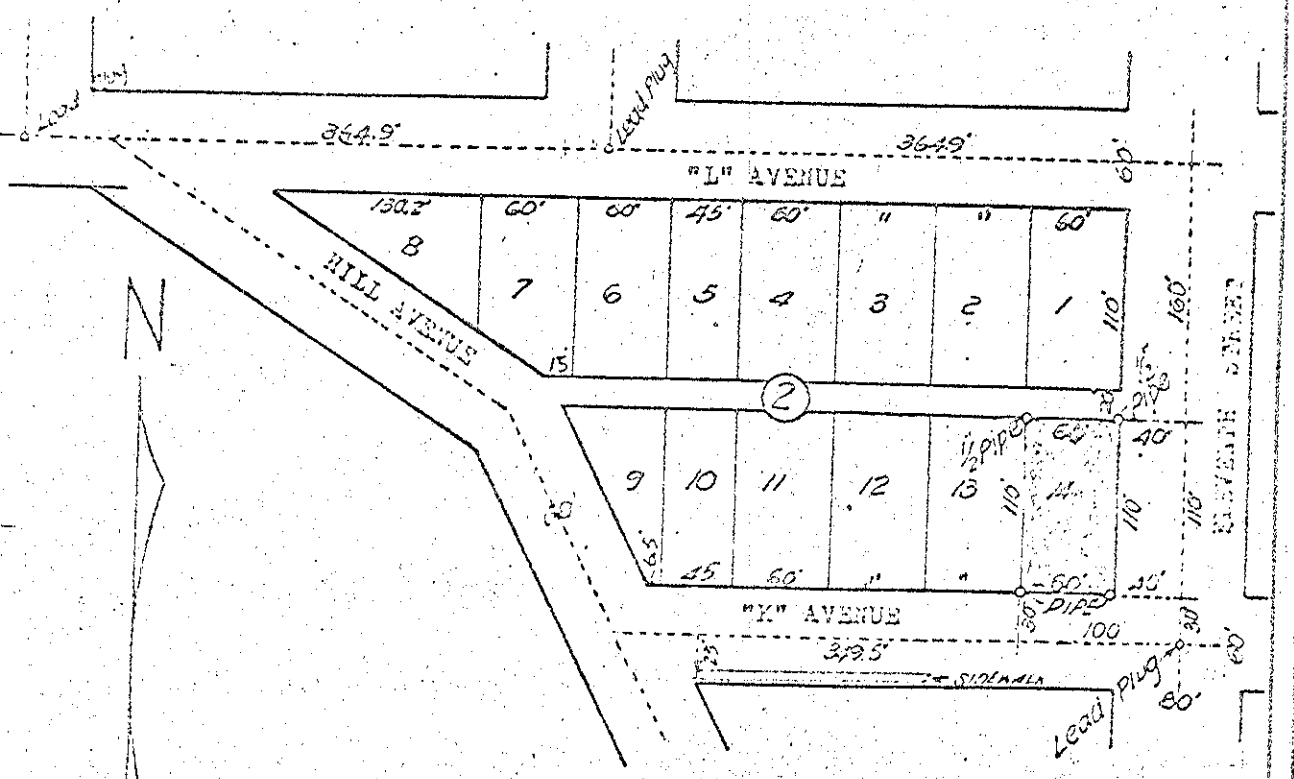

SCALE 1"=100'

