SURVEY
OF
LOTS 3,4, & ADJOINING 40' ON EAST SIDE OF LOT 4, BLOCK 1, FOLEY'S SUBDIVISION OF TRACT C ROMIG'S ADDITION TO LA GRANDE, OREGON.

MAY 25, 1950.

FOR RAY B. McFARLAND
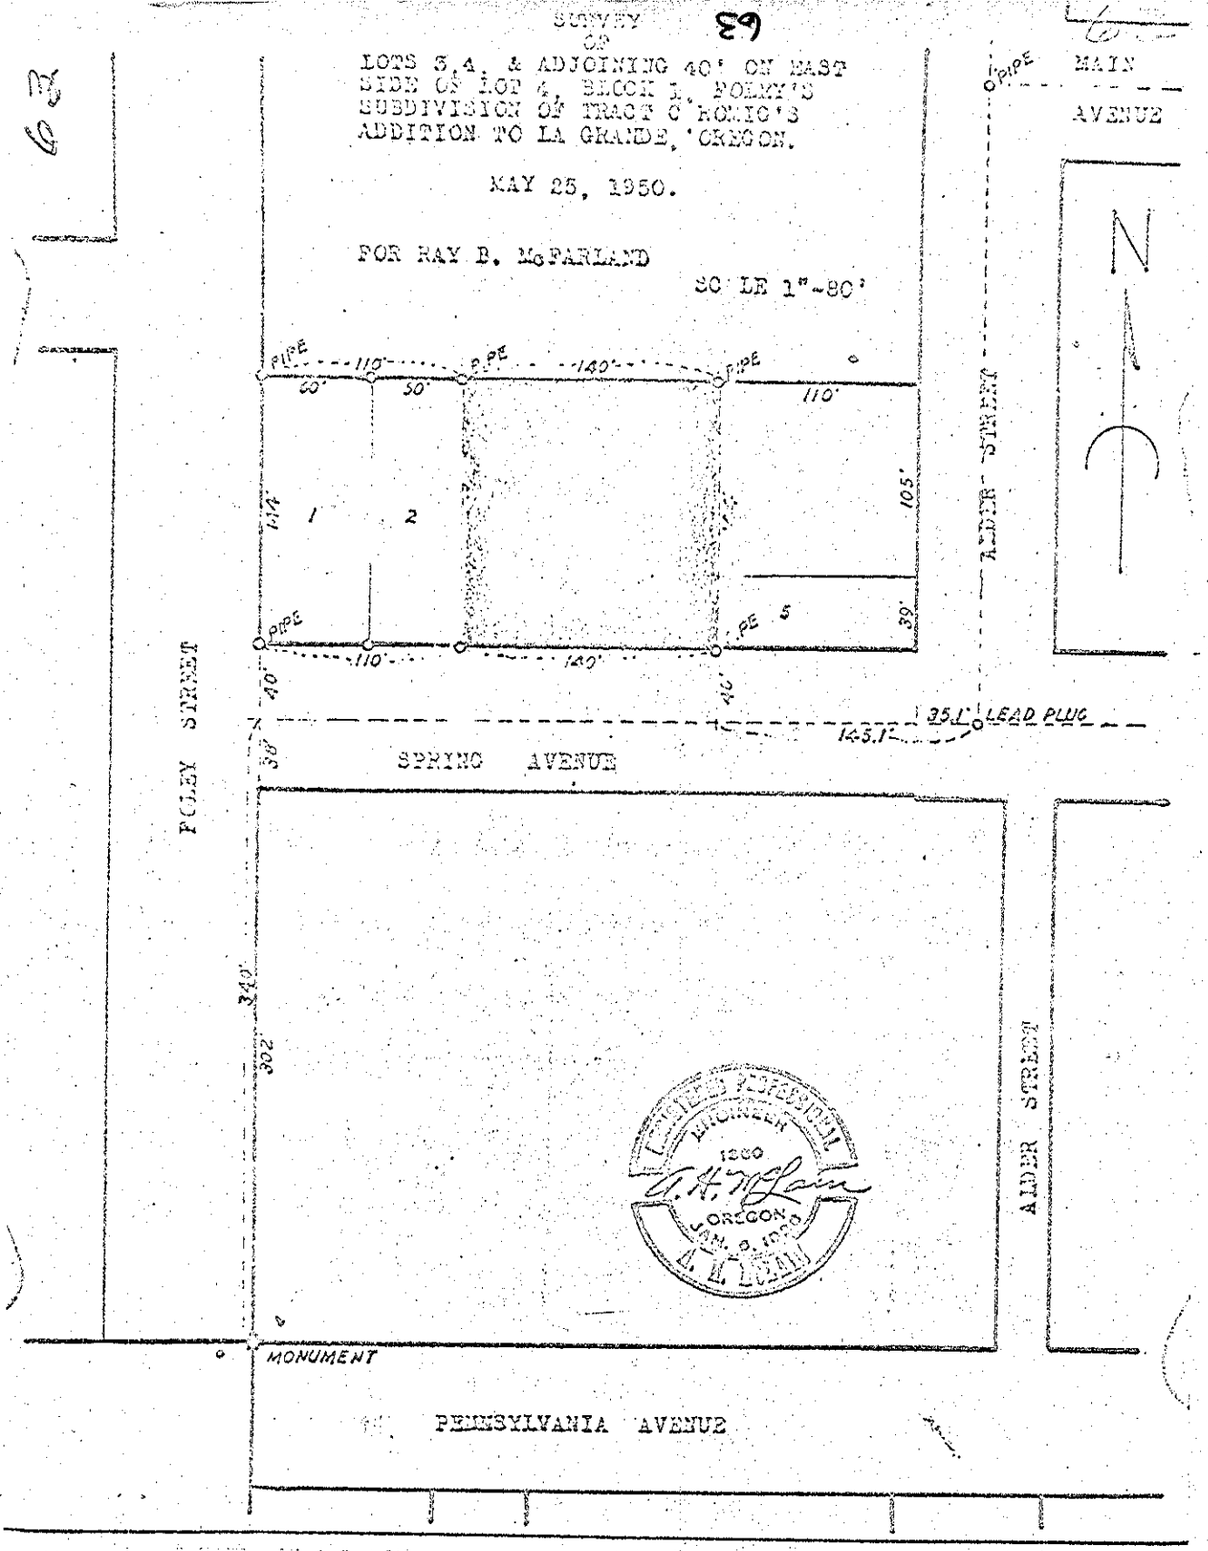
SCALE 1"=80'