

99

99


66

SURVEY  
OF  
LOT "P" & EAST 30' LOT "O" FOR GEO. W. BROOKS

&  
LOT "Q" FOR C. L. GILSTRAP

ALL IN GANGLOFF'S 2ND ADDITION TO LA GRANDE OREGON

6-21-54

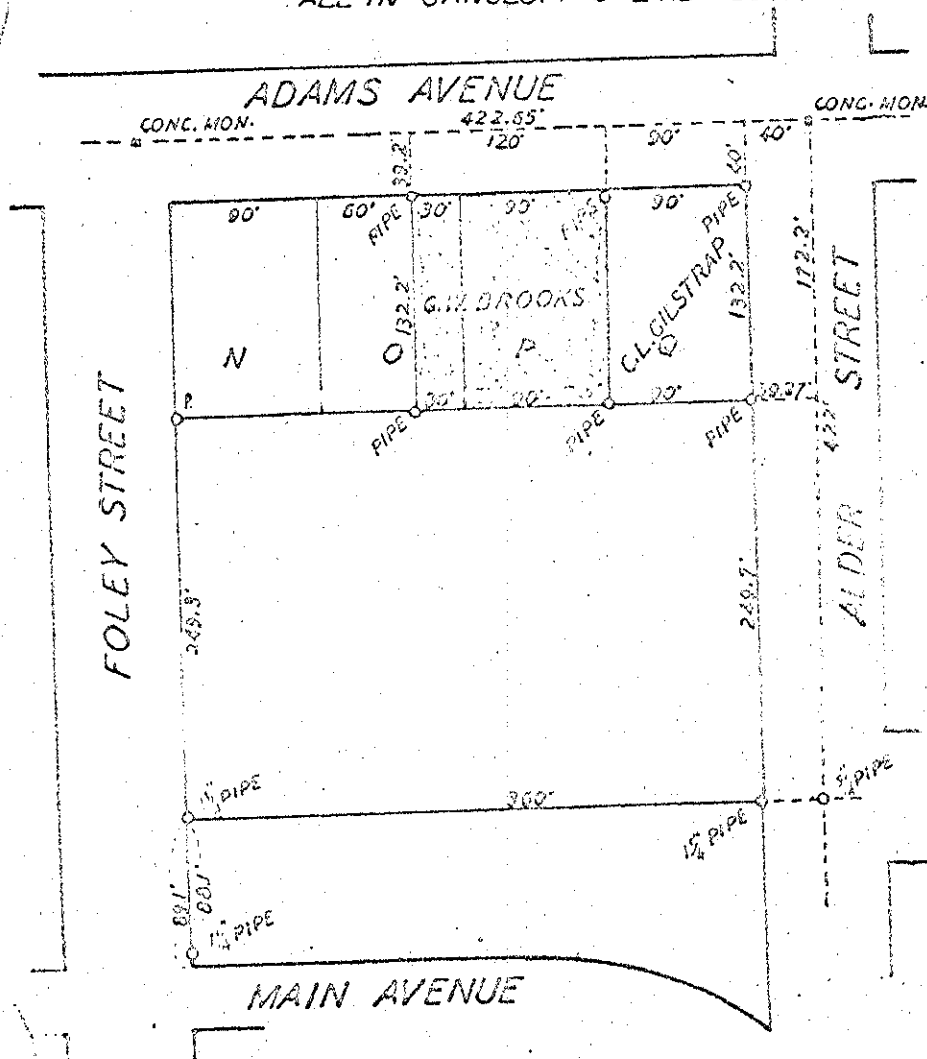

SCALE 1"=100'

66

99