


69

69

69

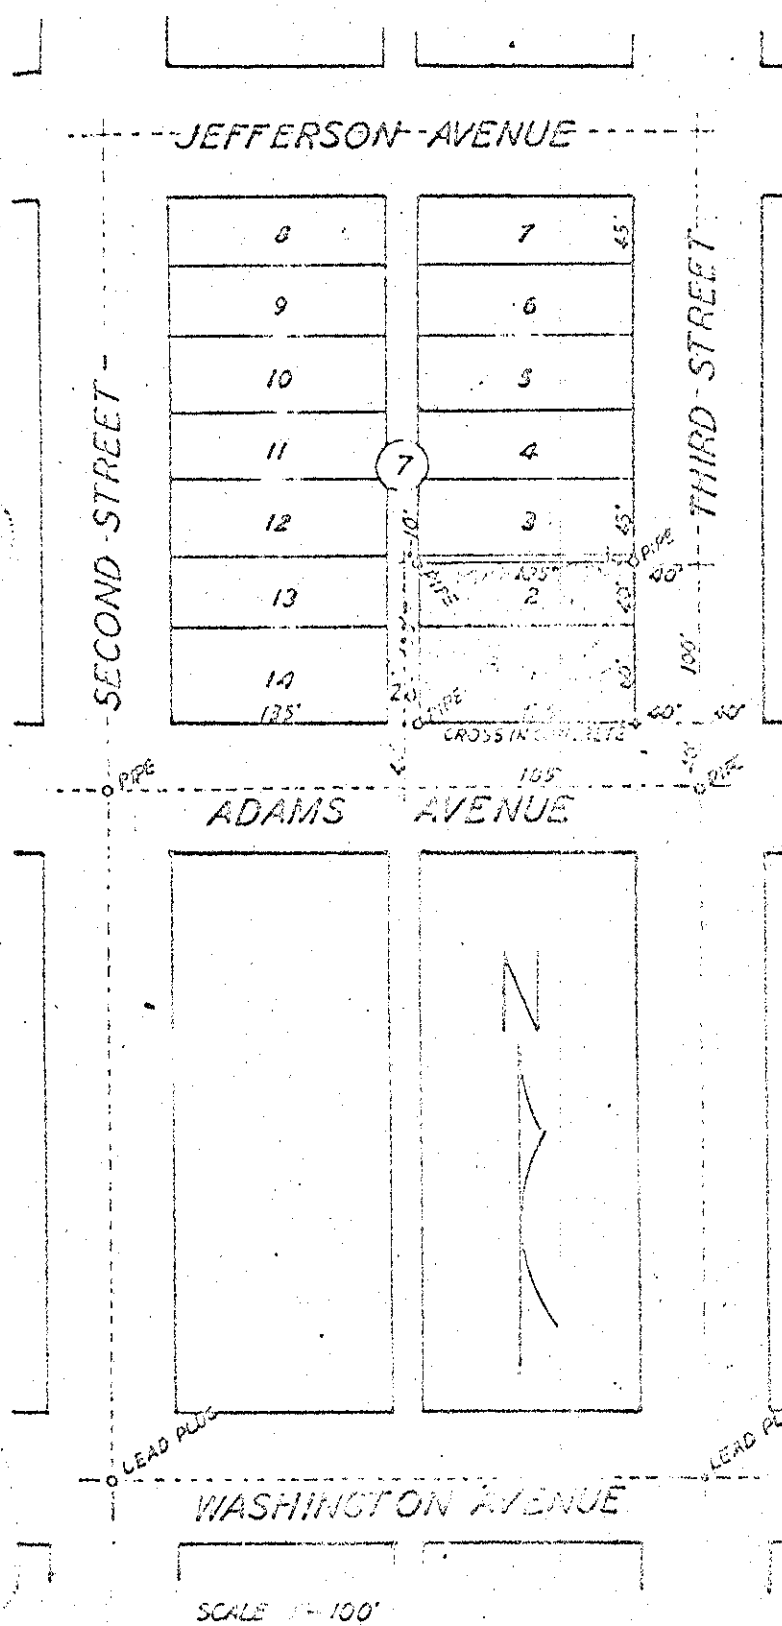

SURVEY
 OF
 LOT 1 & SOUTH 40' LOT 2 BLK
 GRANDY'S ADDITION
 LA GRANDE, OREGON.
 FOR RICHFIELD OIL CO.
 5-8-54

36 33 6 01 4600



SCALE 1" = 100'

69