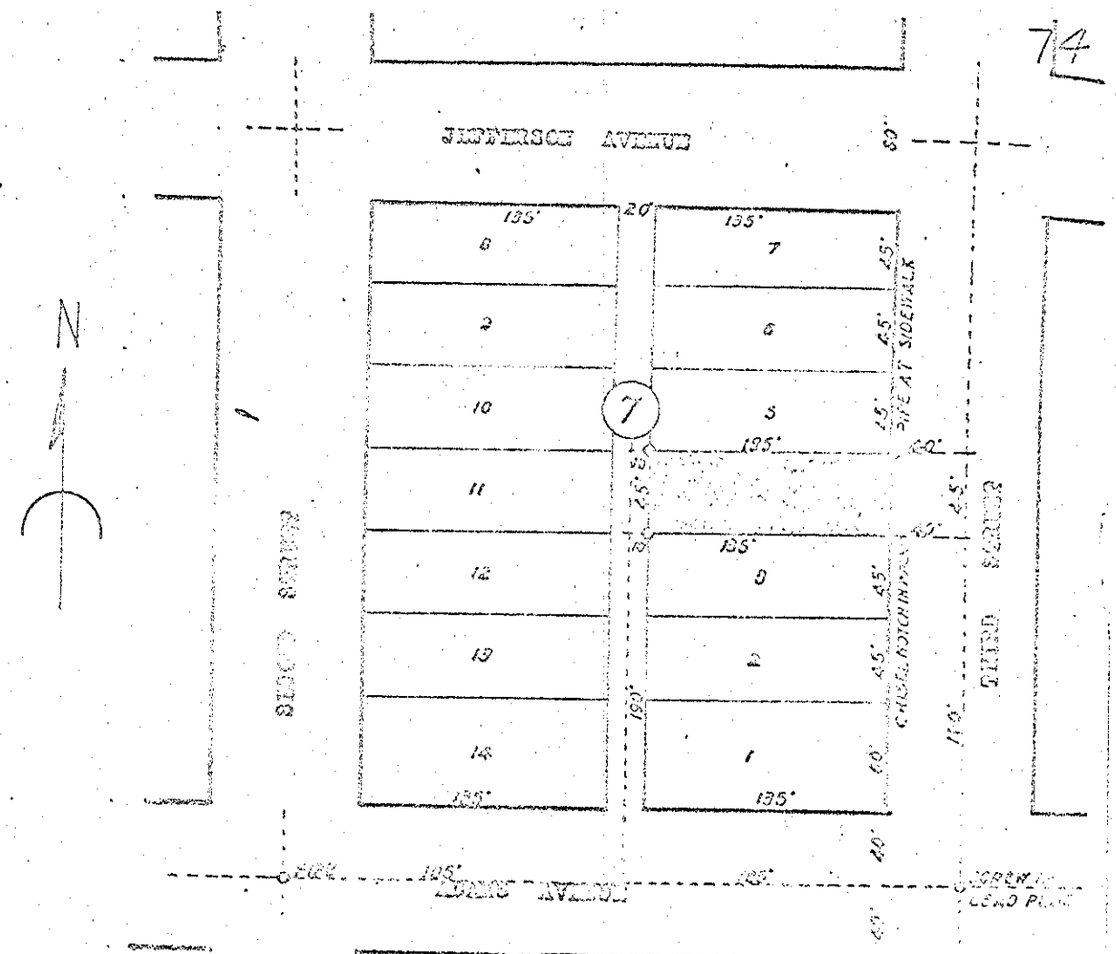
JEFFERSON AVENUE
N
135'
20'
8
7
2
6
10
5
11
12
9
13
4
14
1
7
45'
SITE AT SIDEWALK
60'
25'
190'
110'
40'
135'
BLOCK 8
BLOCK 9
LOCUST AVENUE
3 38 6DA 4800
SURVEY
OF
LOT 4, BLOCK 7, GRANDY'S ADDITION
TO
LA GRANDE, OREGON
6-23-80
SCALE 1" = 60'
WASHINGTON
AVENUE