
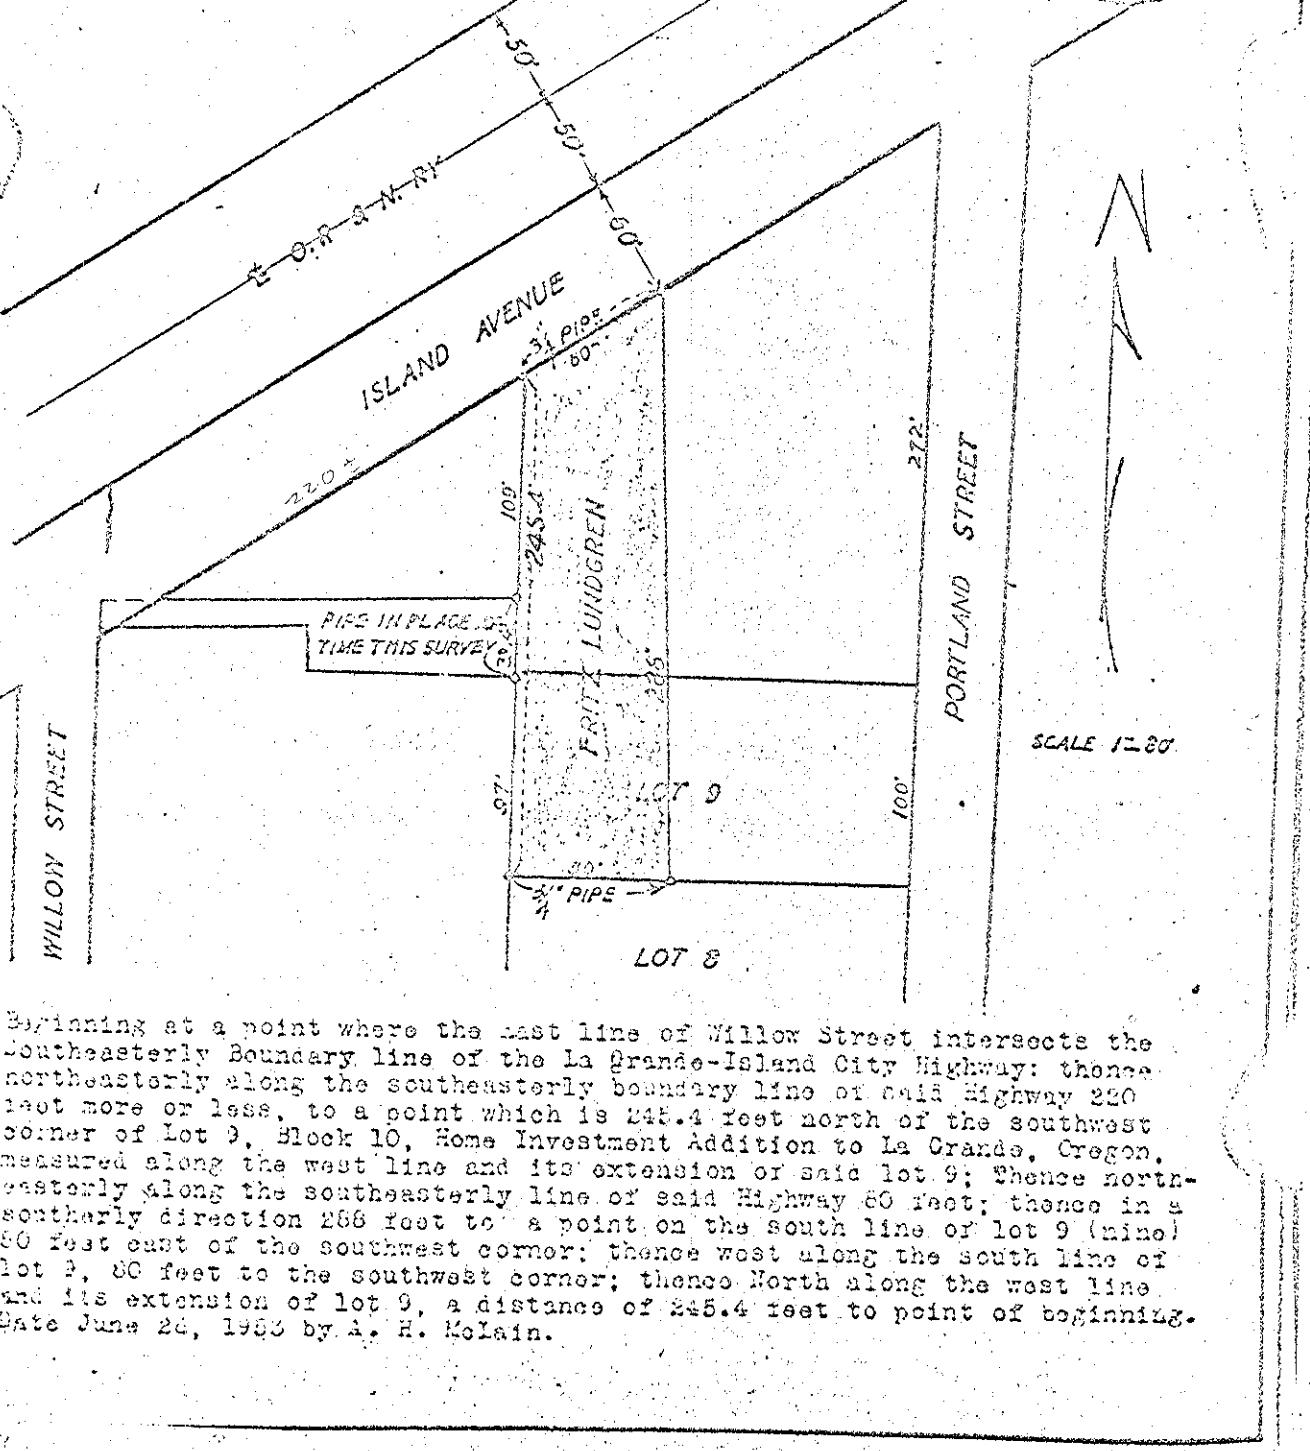


75
SURVEY
FOR
FRITZ LUNDGREN

SL

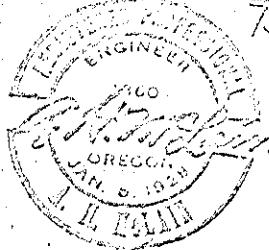

Beginning at a point where the east line of Willow Street intersects the southeasterly Boundary line of the La Grande-Island City Highway: thence northeasterly along the southeasterly boundary line of said Highway 220 foot more or less, to a point which is 245.4 feet north of the southwest corner of lot 9, Block 10, Home Investment Addition to La Grande, Oregon, measured along the west line and its extension of said lot 9; thence northeasterly along the southeasterly line of said Highway 60 feet; thence in a southerly direction 288 feet to a point on the south line of lot 9 (nine) 80 feet east of the southwest corner; thence west along the south line of lot 9, 80 feet to the southwest corner; thence North along the west line and its extension of lot 9, a distance of 245.4 feet to point of beginning.
Date June 26, 1953 by A. H. McLain.