


78


8L

78

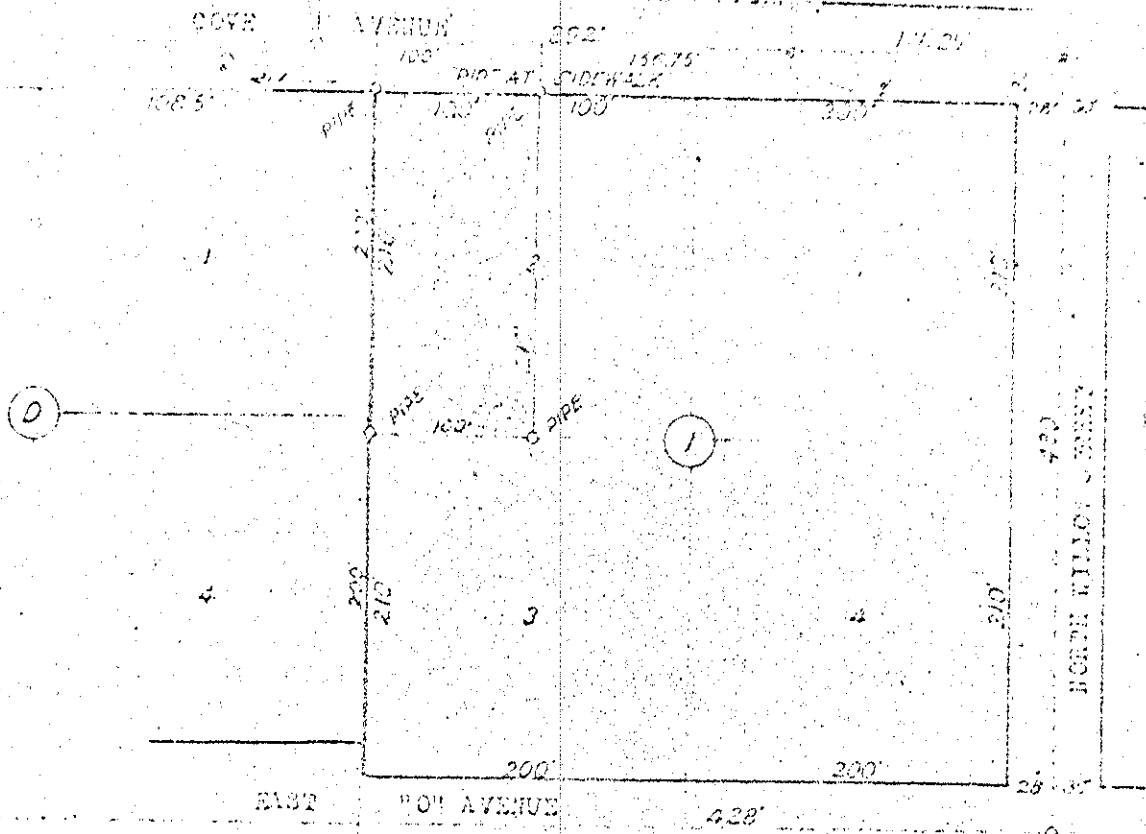

SURVEY
 OF
 1/4 LOT 2, BLOCK 1, HOMAN'S ADDITION
 TO
 LA GRANDE, OREGON.

78

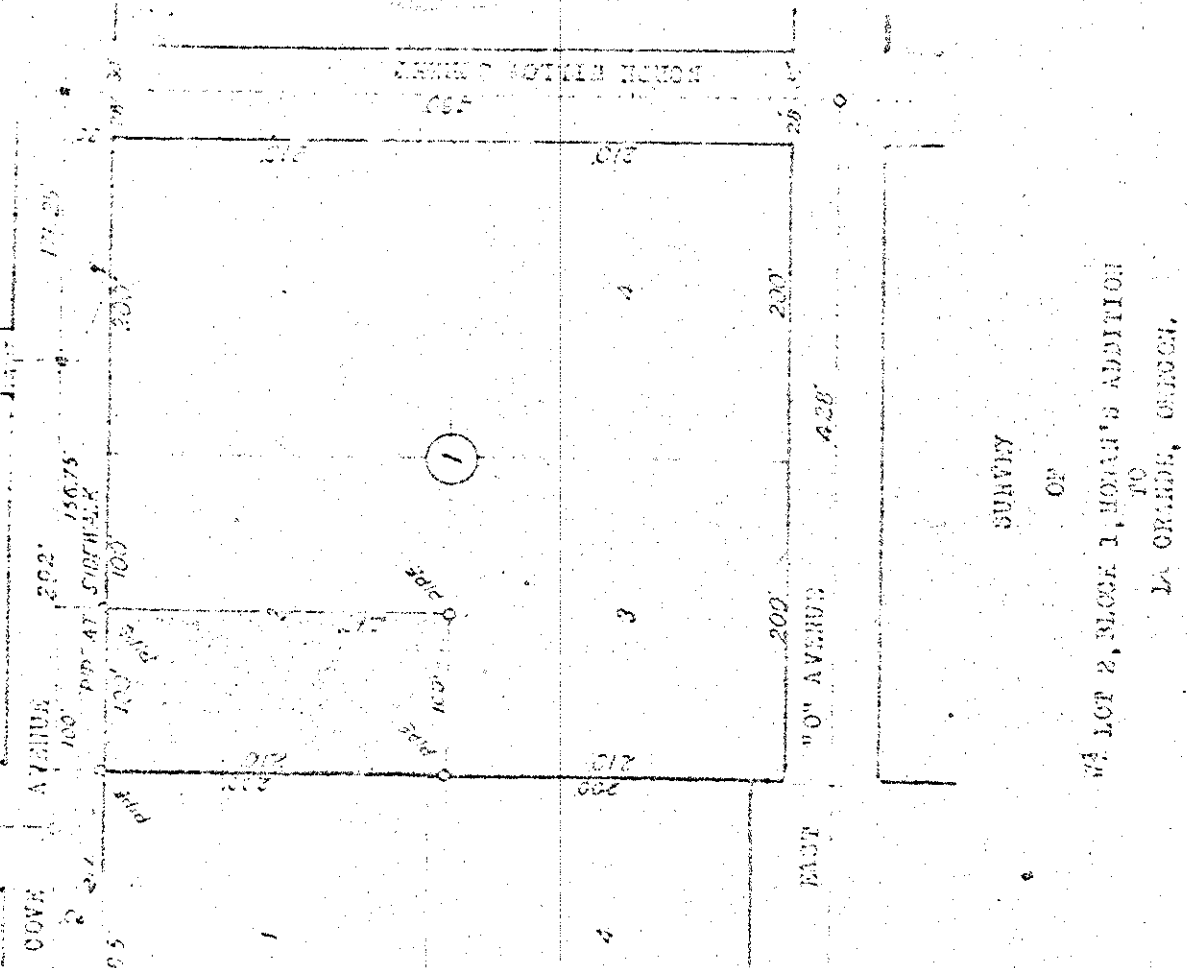

SURVEY
 OF
 1/4 LOT 2, BLOCK 1, HOMAN'S ADDITION
 TO
 LA GRANDE, OREGON.

FOR CHAS. E. HELGEL
 DATED: JUNE 1, 1917.
 SCALE 1" = 100'



78