


SURVEY
 OF
 EAST 80' LOT 24, BLOCK 1, PLEASANT HOLE
 ADDITION TO LA GRANDE, OREGON
 FOR CLARA BECKER 10-22-63

SCALE 1" = 80'

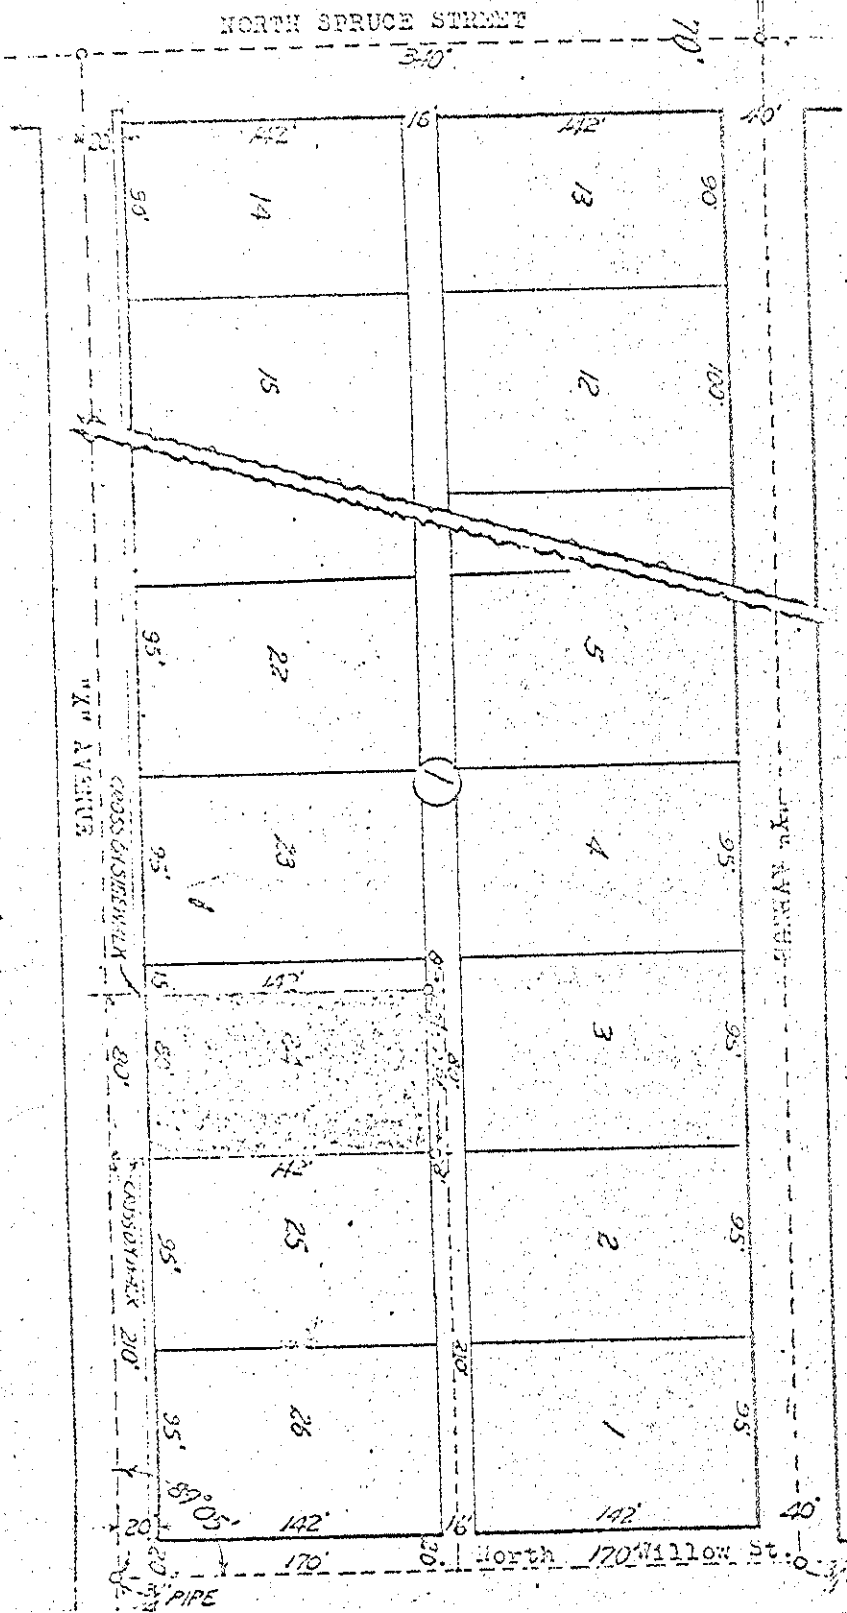

84