


85

50

85

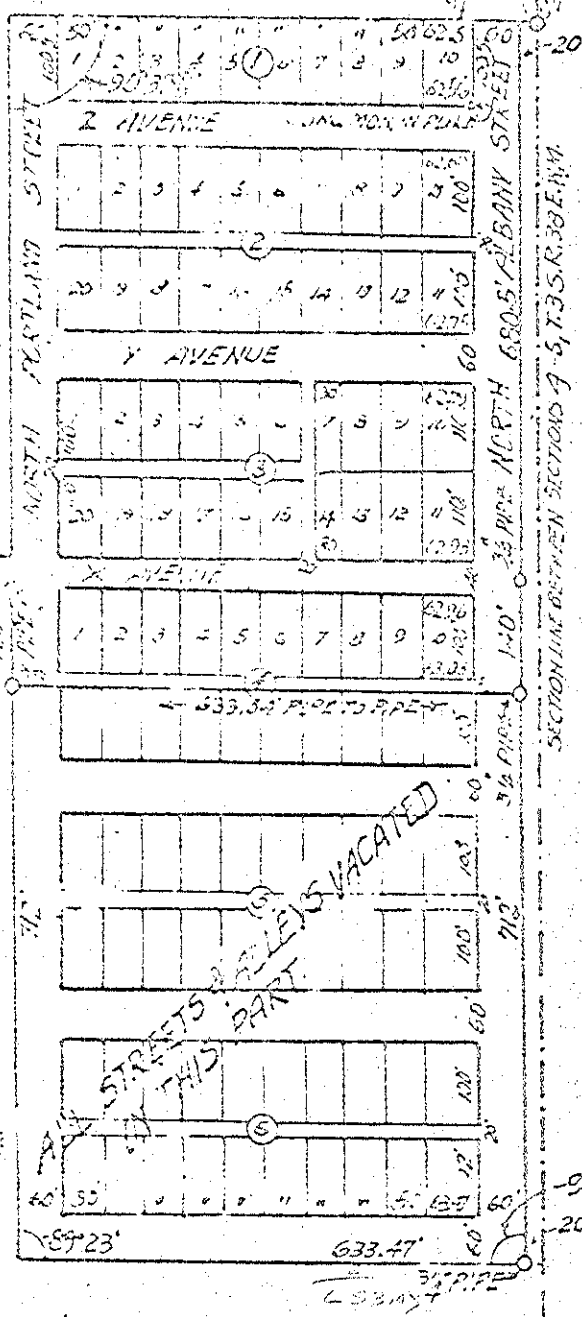

SURVEY  
OF  
SOUTH PART  
OF  
PRATT'S SUBDIVISION  
IN SECTION 5, T.3 S.R.38 E.W.M.  
FOR MT. EMILY LBR. CO.  
JULY 9-11, 1953.  
SCALE 1"=200'

1292  
1952

