86

86

Corrected plat
of
Predmore Addition to City
of
La Grande, Oregon
Plat book 1, Page 35, Aug 4, 1890

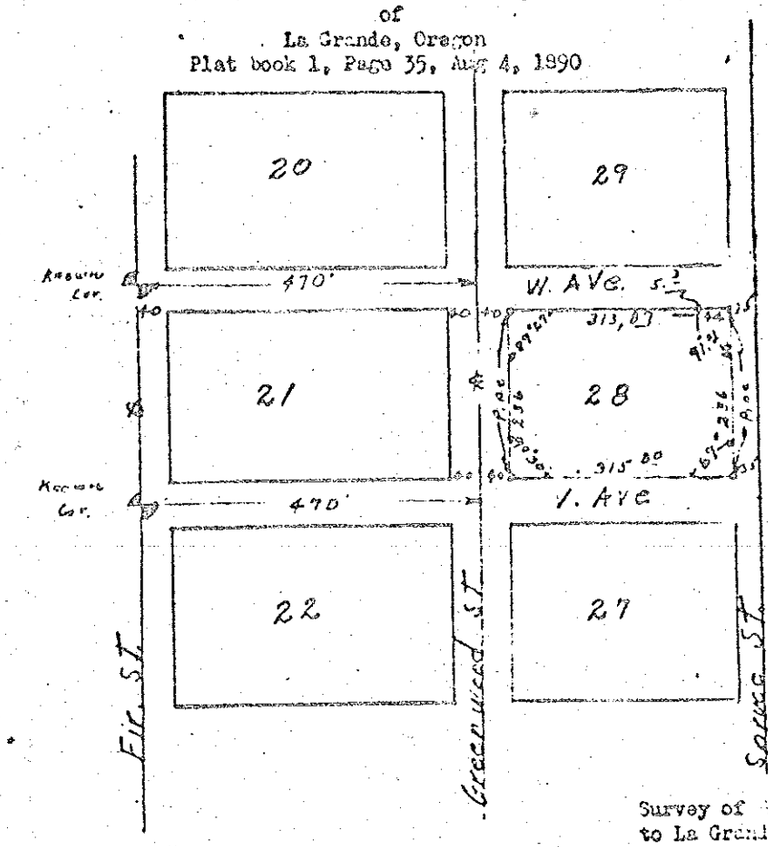

NE cor of new gym
is 5.3' south and 44'
west of NE Cor of
Blk 28 of Predmore
Addition of
La Grande, Oregon.

N

Scale 1" = 200'

3 38 560 12700

Survey of Blk. 28 of Predmore Addition
to La Grande, Oregon. Survey completed
May 1959 and found to be as shown.

REGISTERED
OREGON
LAND SURVEYOR
James G. Voelz
MAY 4, 1953
JAMES G. VOELZ
381