


3 38 58D 13400

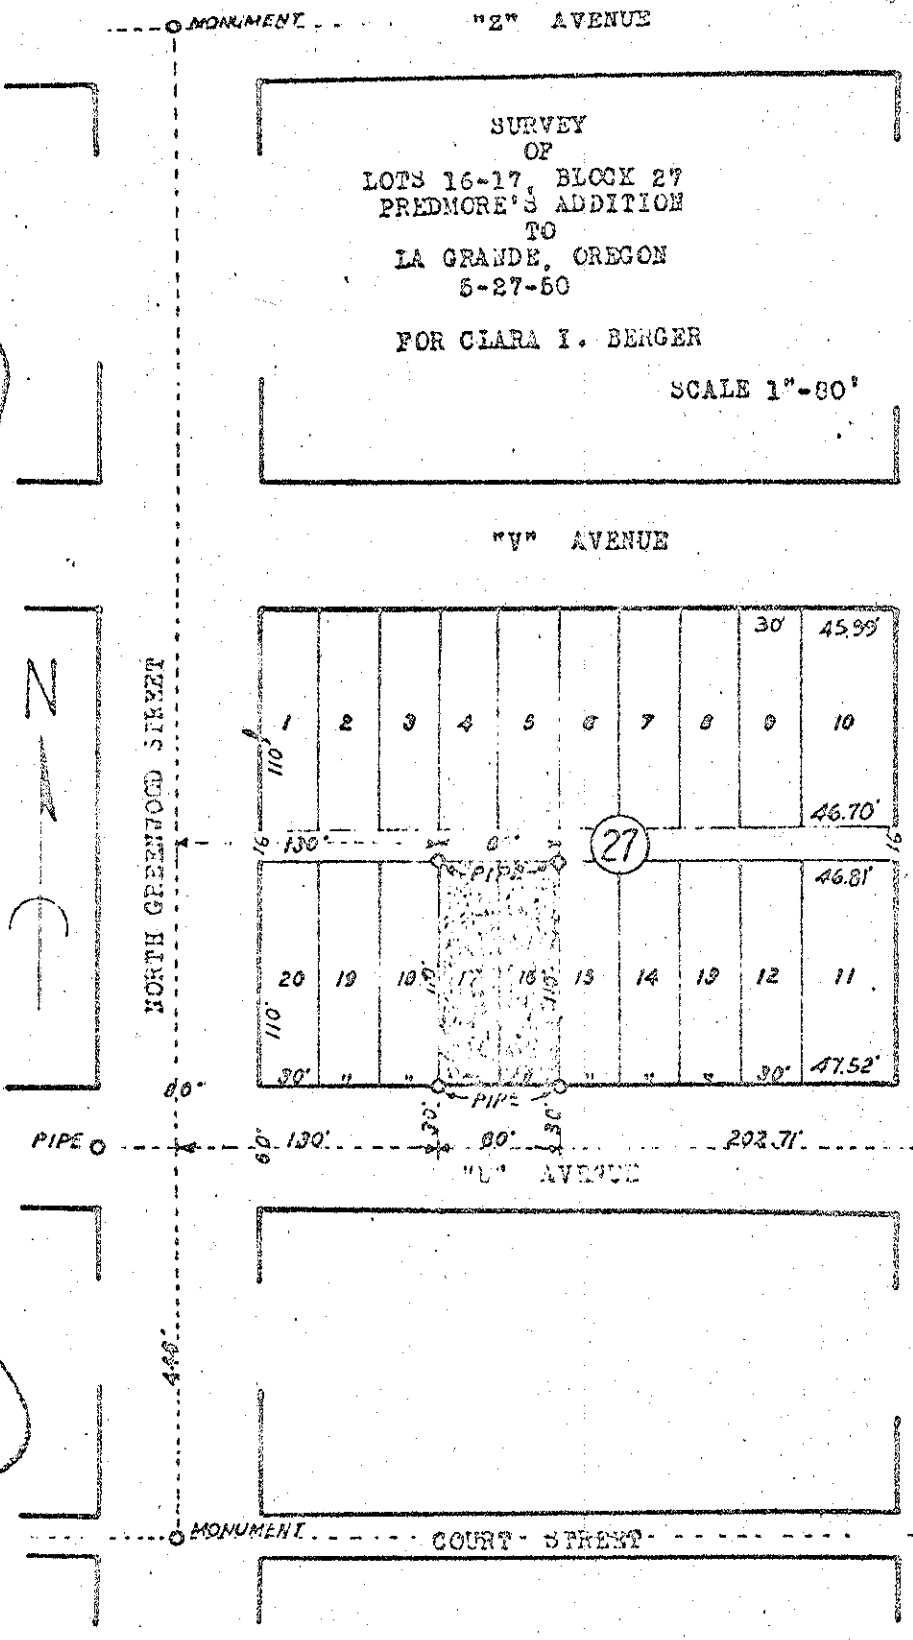

SURVEY  
OF  
LOTS 16-17, BLOCK 27  
PREDMORE'S ADDITION  
TO  
LA GRANDE, OREGON  
6-27-60

FOR CIARA I. BENDER

SCALE 1"=80'

"V" AVENUE

NORTH GREENFORD STREET


"U" AVENUE

MONUMENT COURT STREET

