


PREDMORES ADDITION
to
La Grande, Oregon

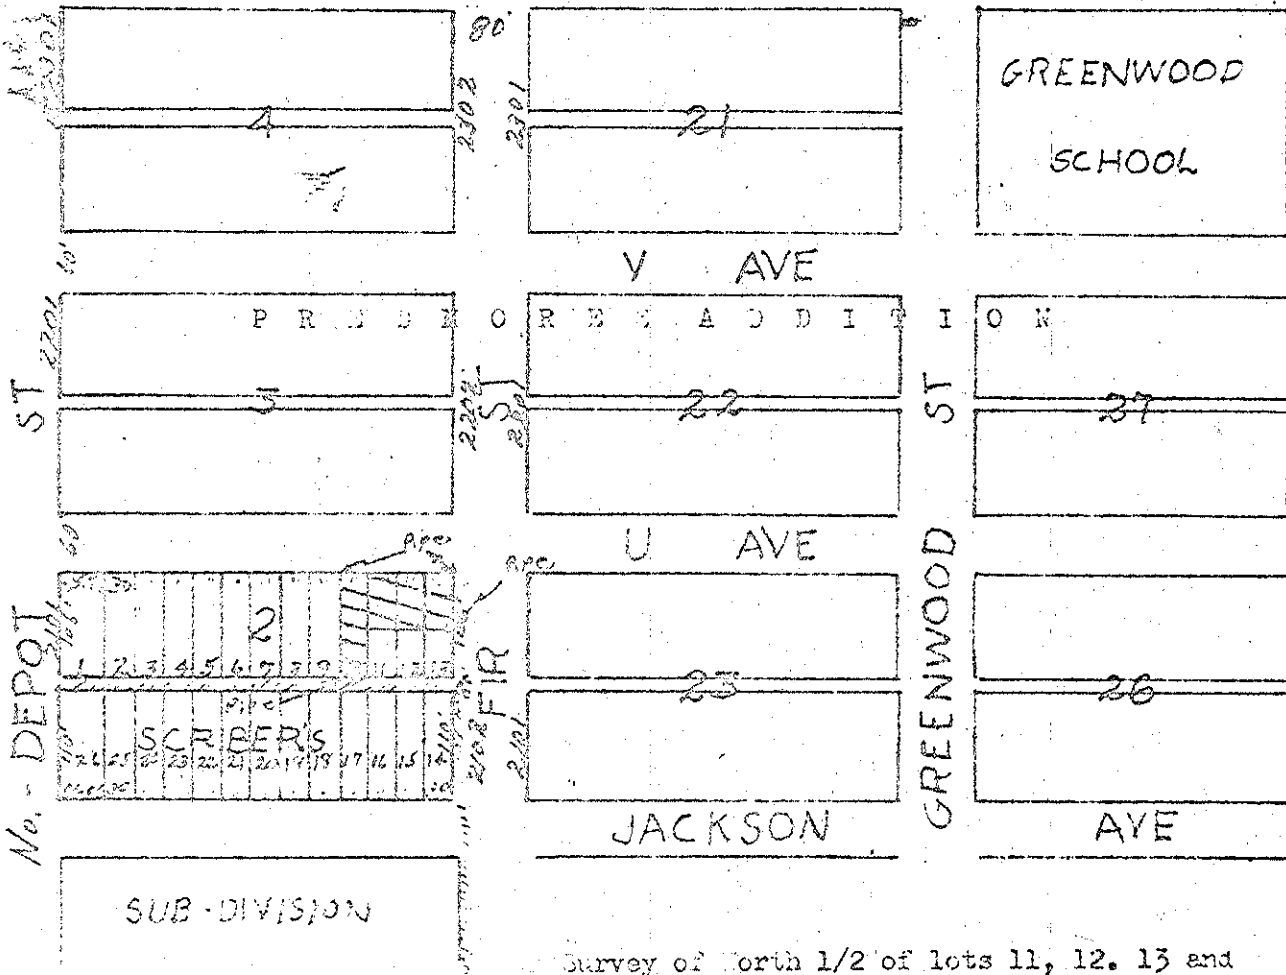

Survey of North 1/2 of lots 11, 12, 13 and lot 10 of block 2 of Predmores Addition to La Grande, Oregon.

scale 1" = 200'

I certify this survey completed by me in July 1959.

REGISTERED
OREGON
LAND SURVEYOR
James G. Voelz
MAY 4, 1958
JAMES G. VOELZ
381