
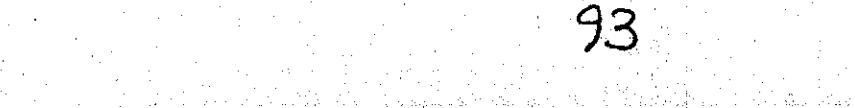
 
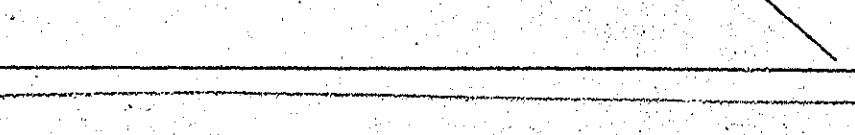
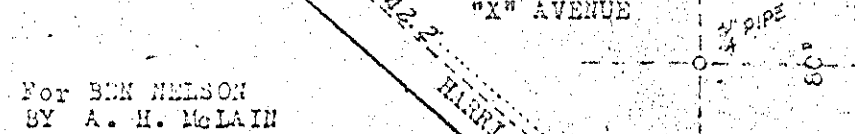
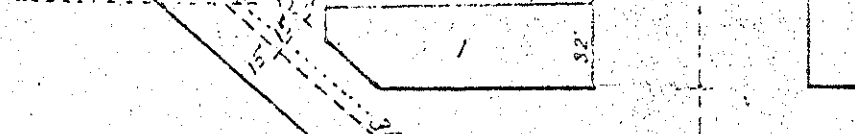
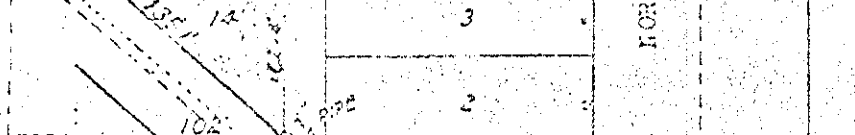
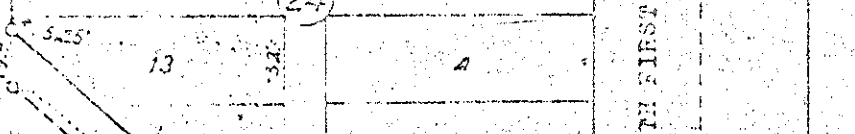
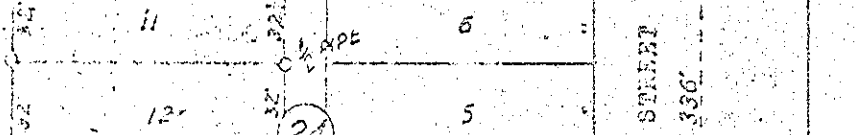
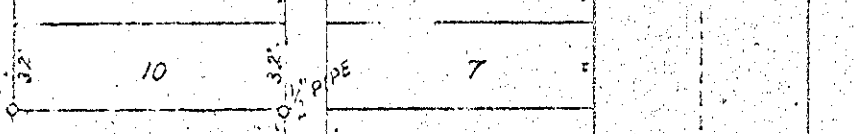
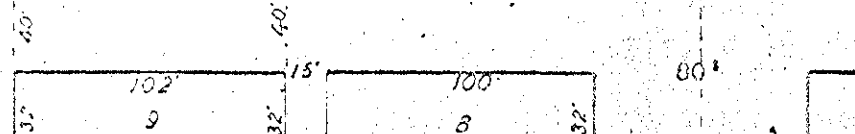



93

OF
11
LOTS 12-13-14, BLOCK 24,
RIVERSIDE ADDITION TO LA GRANDE, OREGON.

NORTH CEDAR STREET

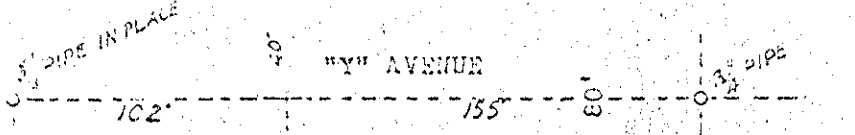

PIPE IN PLACE
CONCRETE MONUMENT

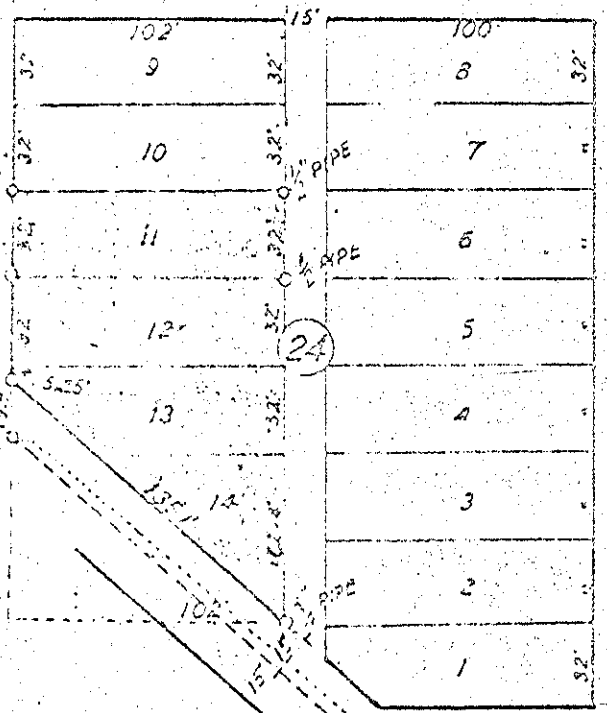

NORTH FIRST STREET

"X" AVENUE
HARRISON AVENUE

For BEN NELSON
BY A. H. McLAIN
Date: AUGUST 1, 1956.
SCALE 1" = 60'

