



94

74

SURVEY
 OF
 BLOCK 29, RIVERSIDE ADDITION
 LA GRANDE, OREGON.

4-10-1951

FOR JOE MORTIER

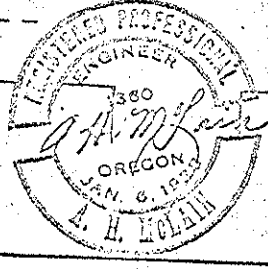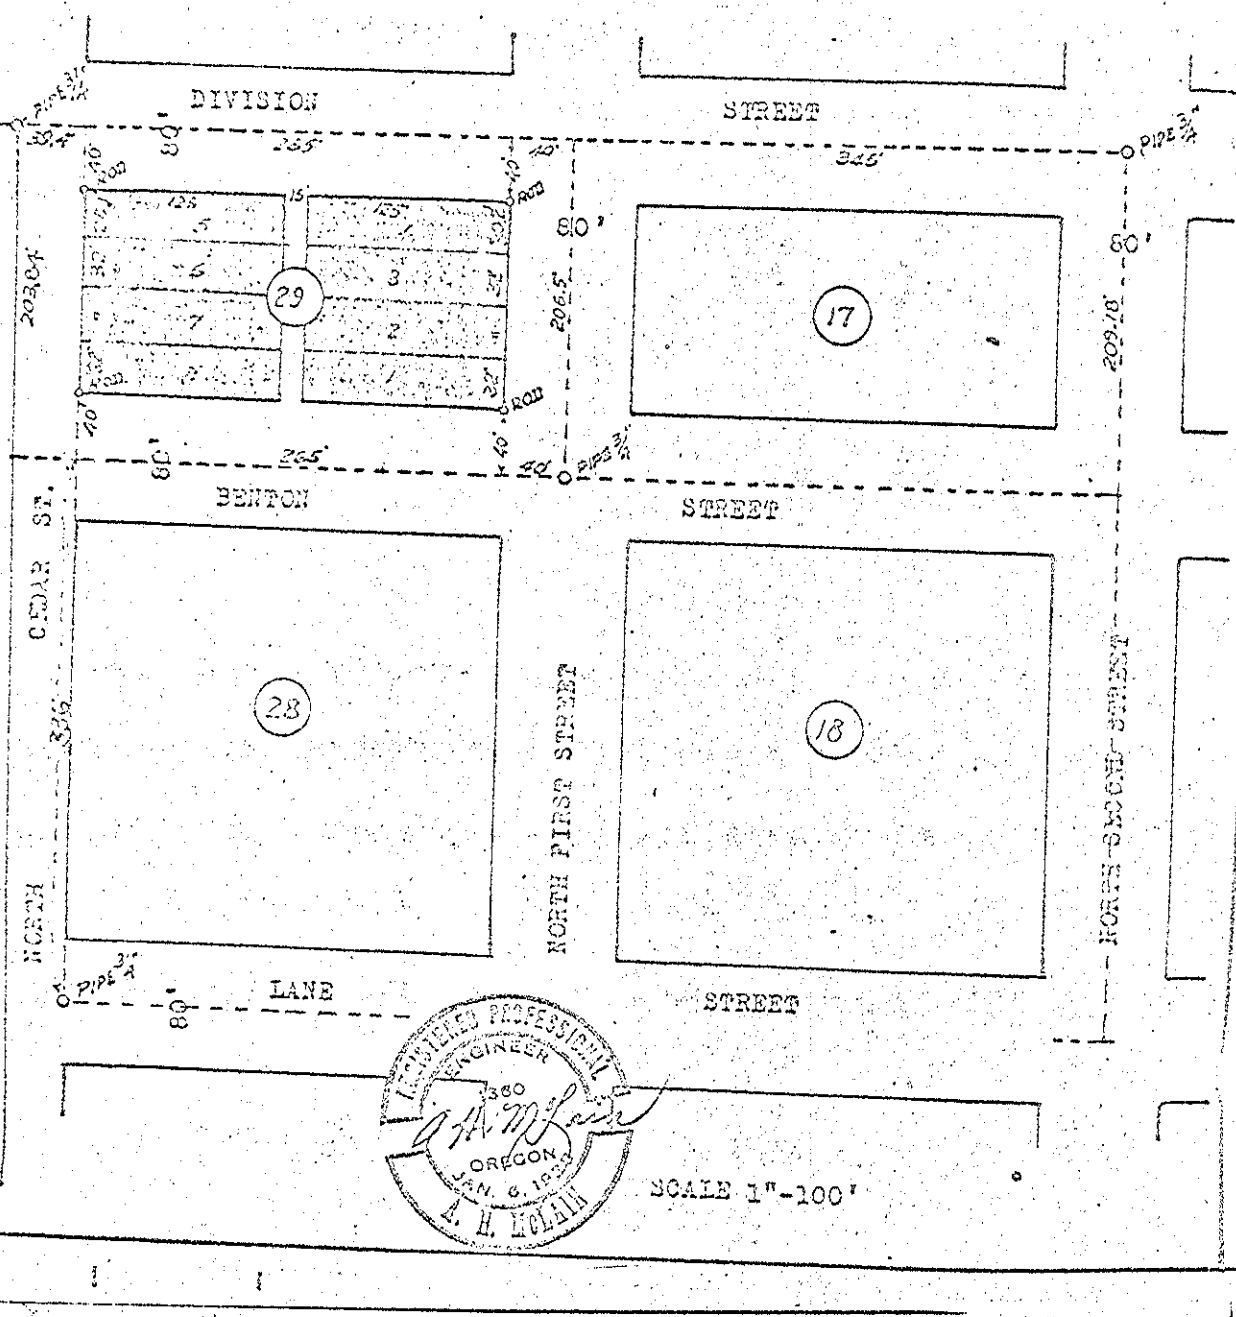

SCALE 1"=100'

94

94