


96


76

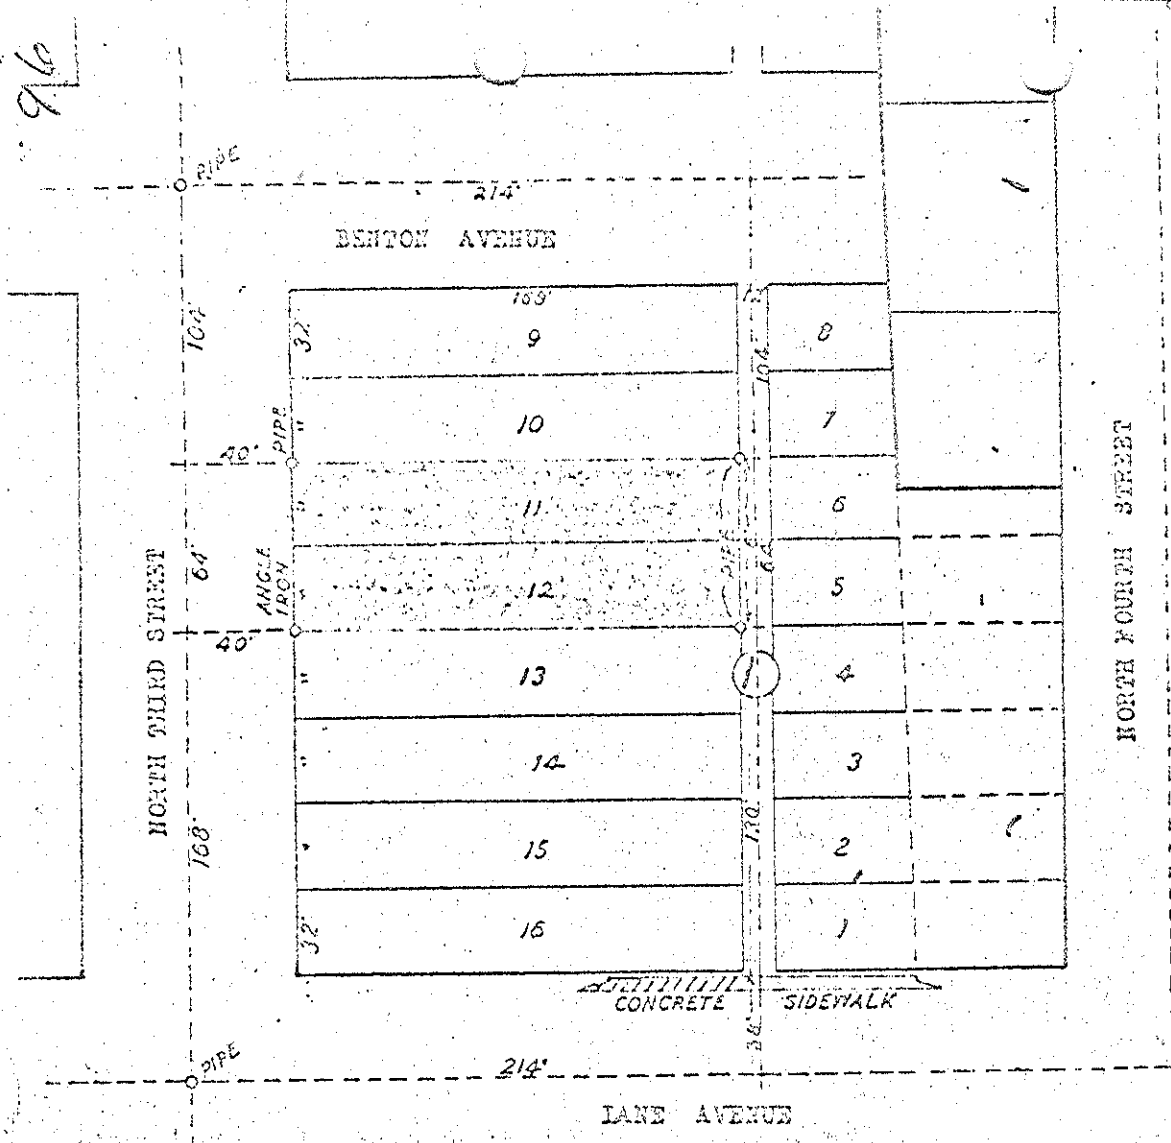

SURVEY
 OF
 LOTS 11 & 12, BLOCK 1
 RIVERSIDE ADDITION TO
 LA GRANDE, OREGON

For W. I. MILLER
 By A. H. McLain

Date: July 7, 1956.
 Scale 1" = 60'

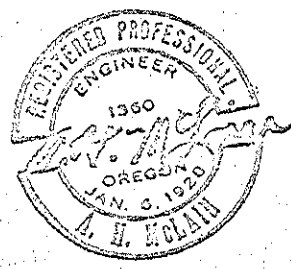

96

96