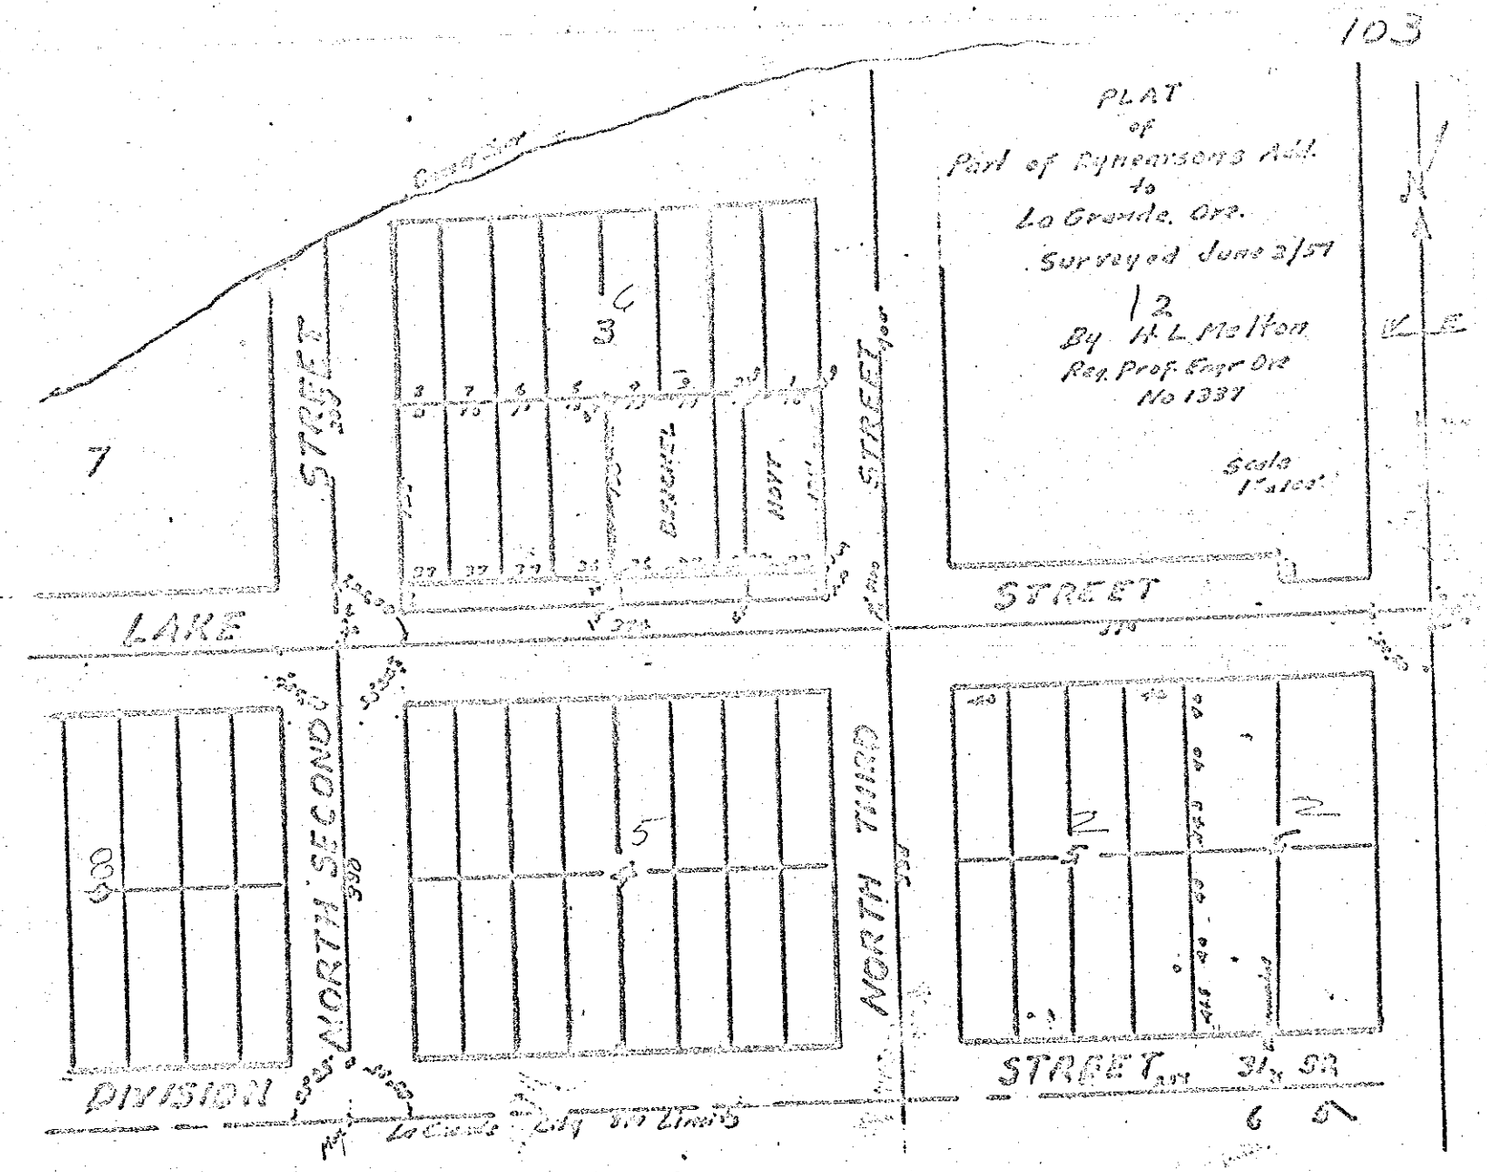
103
PLAT
of
Part of Rynearsons Add.
to
La Grande, Ore.
Surveyed June 3/57
By H. L. Melton
Reg. Prof. Engr Ore
No 1337
Scale
1" = 100'
LAKE
STREET
NORTH SECOND
NORTH THIRD
STREET
DIVISION
BENCHEL
HOYT
La Grande City Limits
7
3
6
5
2
6
5