


Survey for Gowins & Hamilton

107

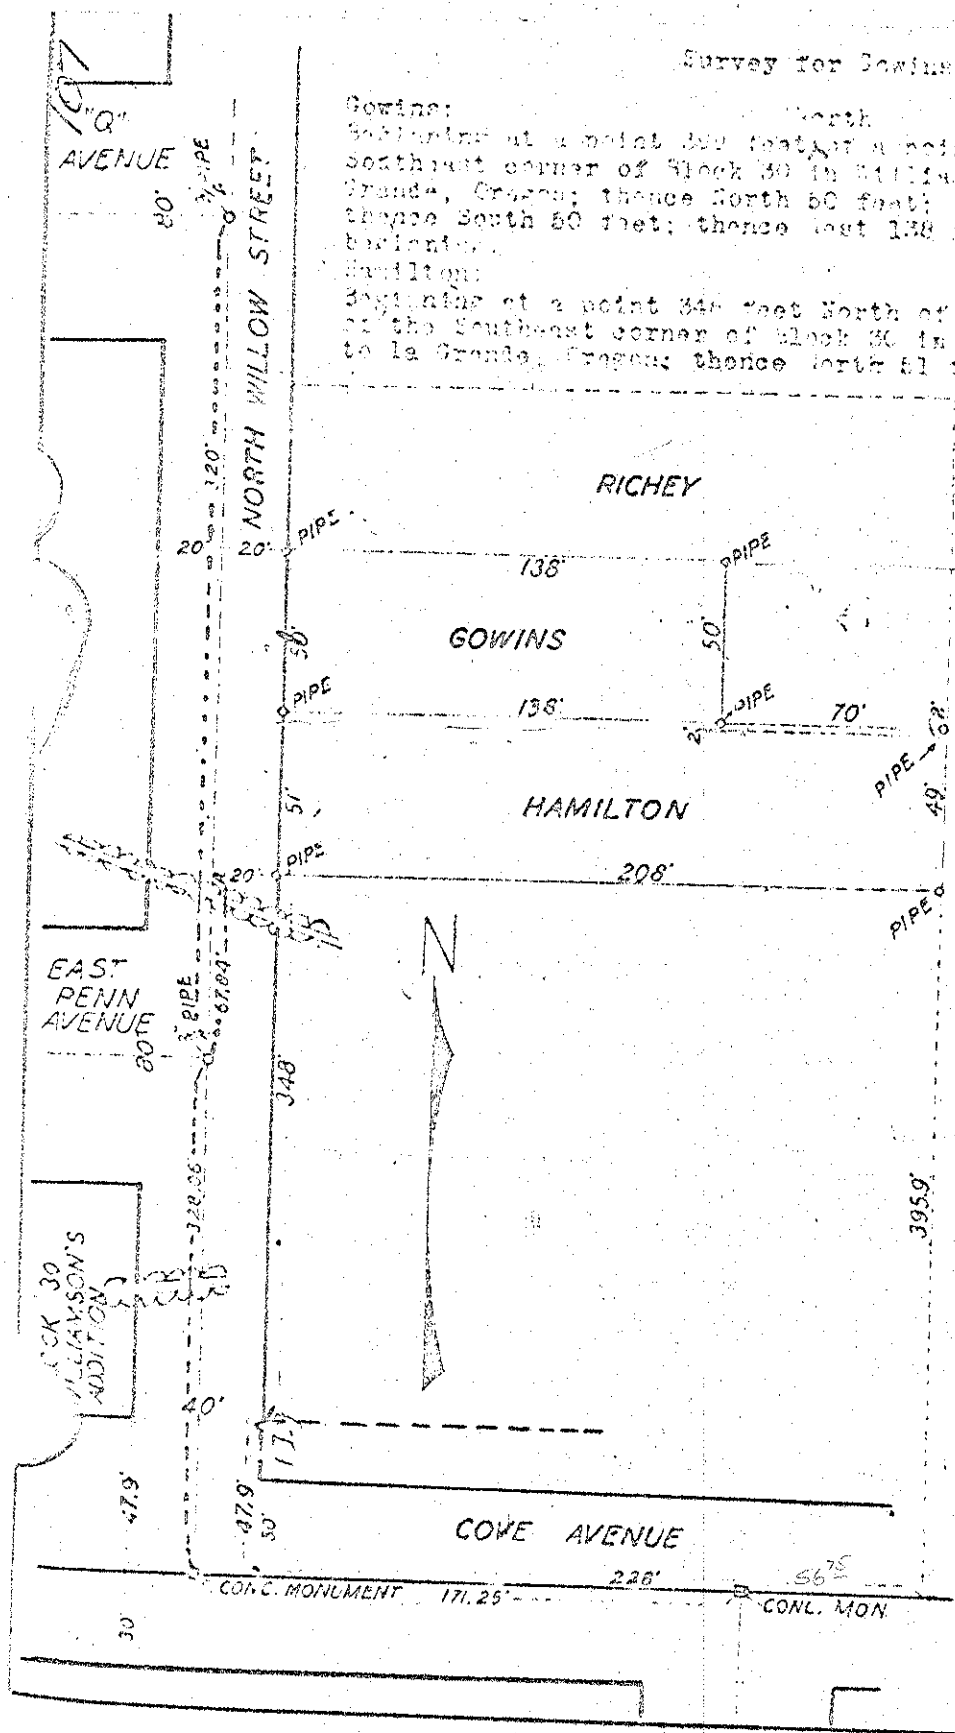

Gowins:

Hamilton:

by A. H. McLean
June 1916.


395.9
11.3

384.6
13.3

11.3

