

109

109

SURVEY

OF


LOTS 7-8-9-10-11-12, BLOCK 6, WISDOM'S ADDICTION

TO


LA GRANDE, OREGON.

FOR HARRY PRATT

11-8-53

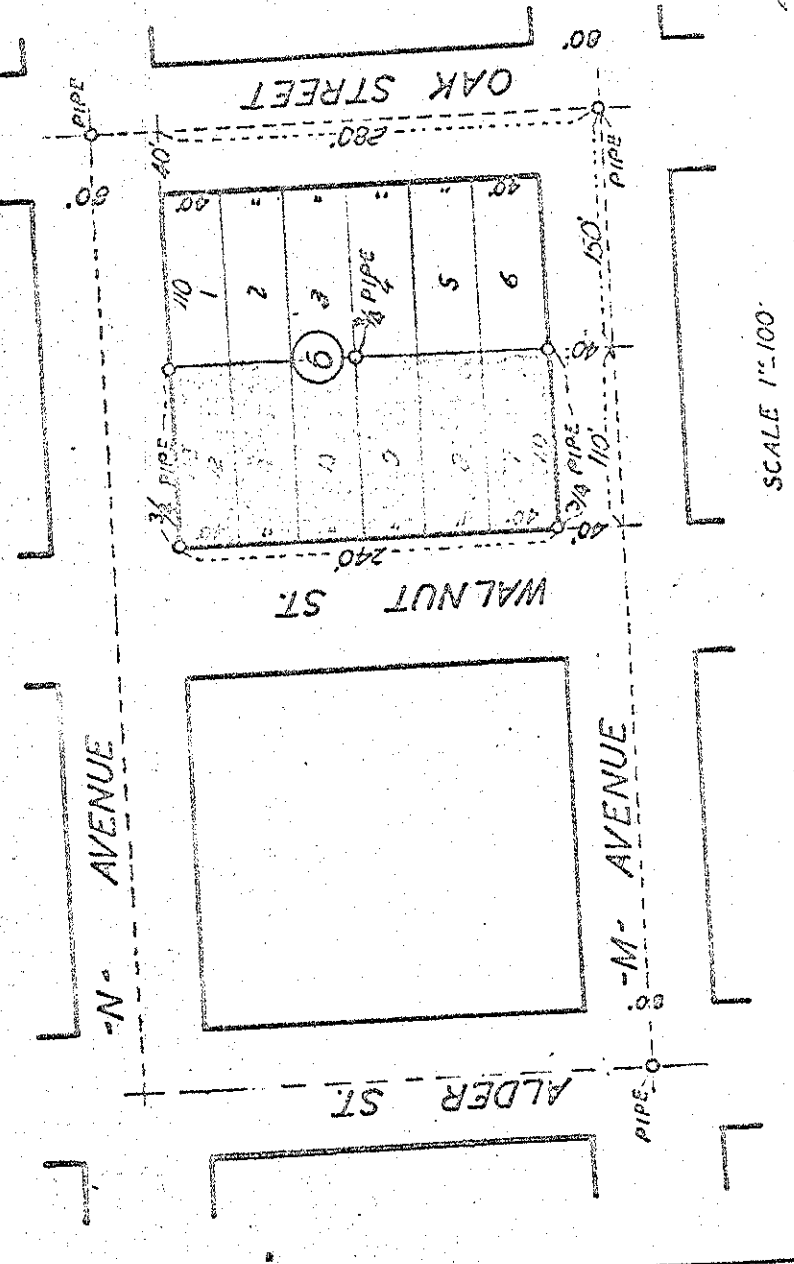

SCALE 1"=100'

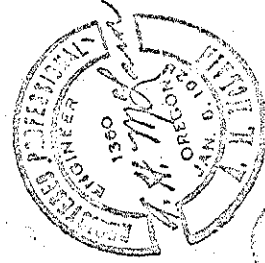

109