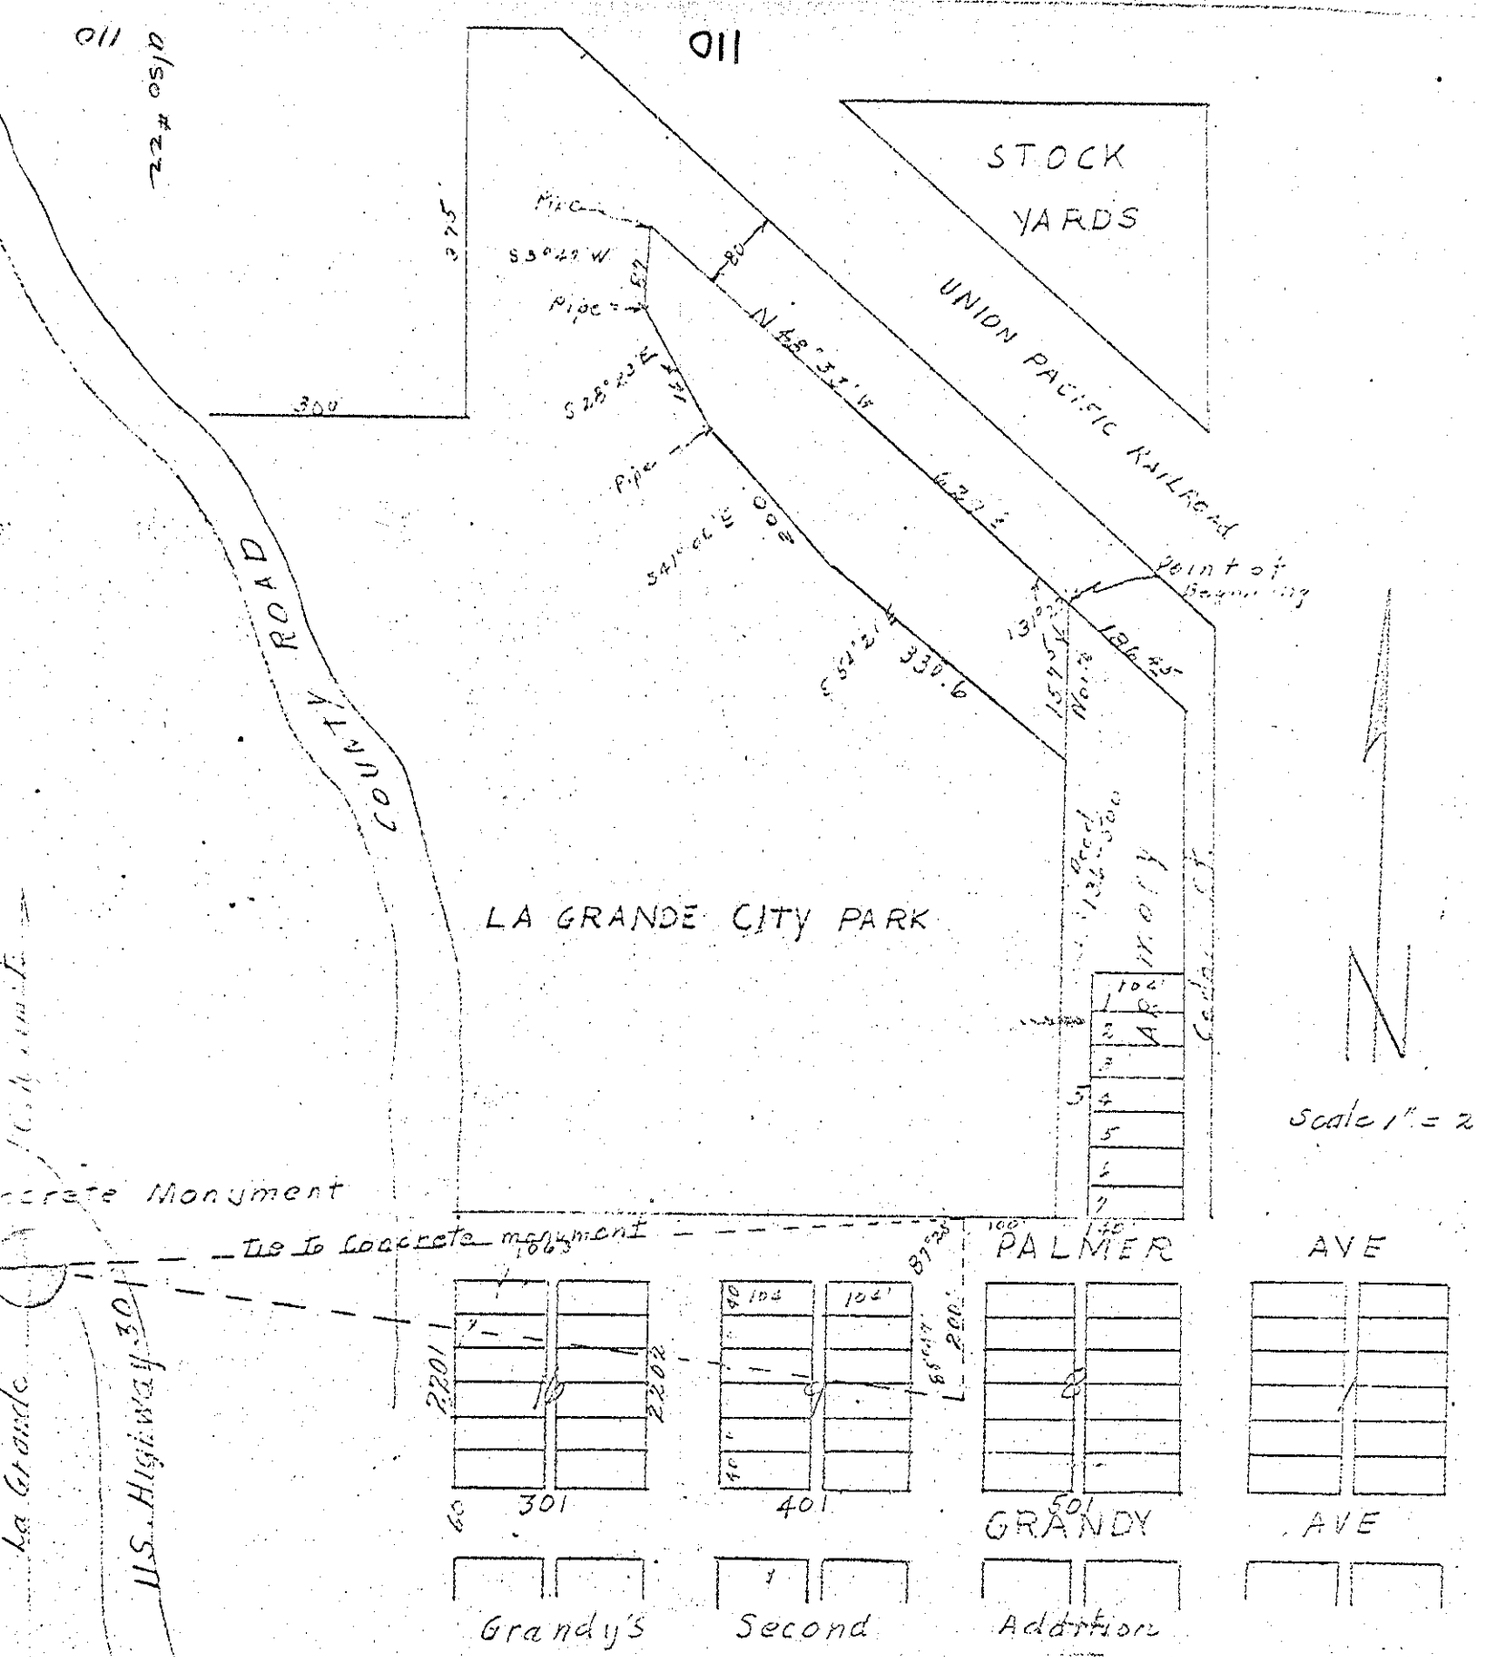

Description:
Point of beginning is 1162 feet east and 741.29 feet north, more or less, of concrete monument at west end of Palmer Ave.; Said concrete monument being center of section 6, T-3-S, R-38-EWM. Point of beginning also being one and same as the Northwest corner of property conveyed by deed in book 136 page 500 of records in Union County Court House of La Grande, Oregon.; Thence, N 48°33'W 629.6 feet. Thence, S 3°47'W 87 feet, Thence, S 28°23' E 164 feet. Thence S 41° 06' E 200 feet. Thence, S 54° 21' E 330.6 feet more or less, t o west line of property deeded in said book (136-500).; Thence north 157.5 feet, more or less, on west line of land deeded in book 136 page 500 of said records to point of beginning.

I certify this survey was completed by me in Aug. 1959.

REGISTERED
OREGON
LAND SURVEYOR
James G. Voelz
MAY 4, 1960
JAMES G. VOELZ