


I certify this survey of Harvey M. & Frank M. Elmer was completed by me in Oct. 1959.

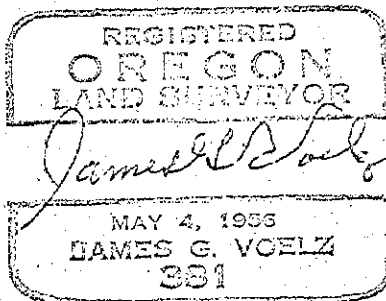

State
Land
Bank

Willie & Mattie
Wright

Scale 4" = 1 mile

T-2-S R-39-E

Original Cor
found 1863

T-2-S R-40-E No. 126

D.B. &
Lela Fleet

Harvey M. & Frank M.
Elmer

Theo E & Anne C.
Johnson

R & R
Becker

Original Cors
found 1863

Merrill F. Conley

Tap Rock Bluff