


U.P.R.R. Right of Way

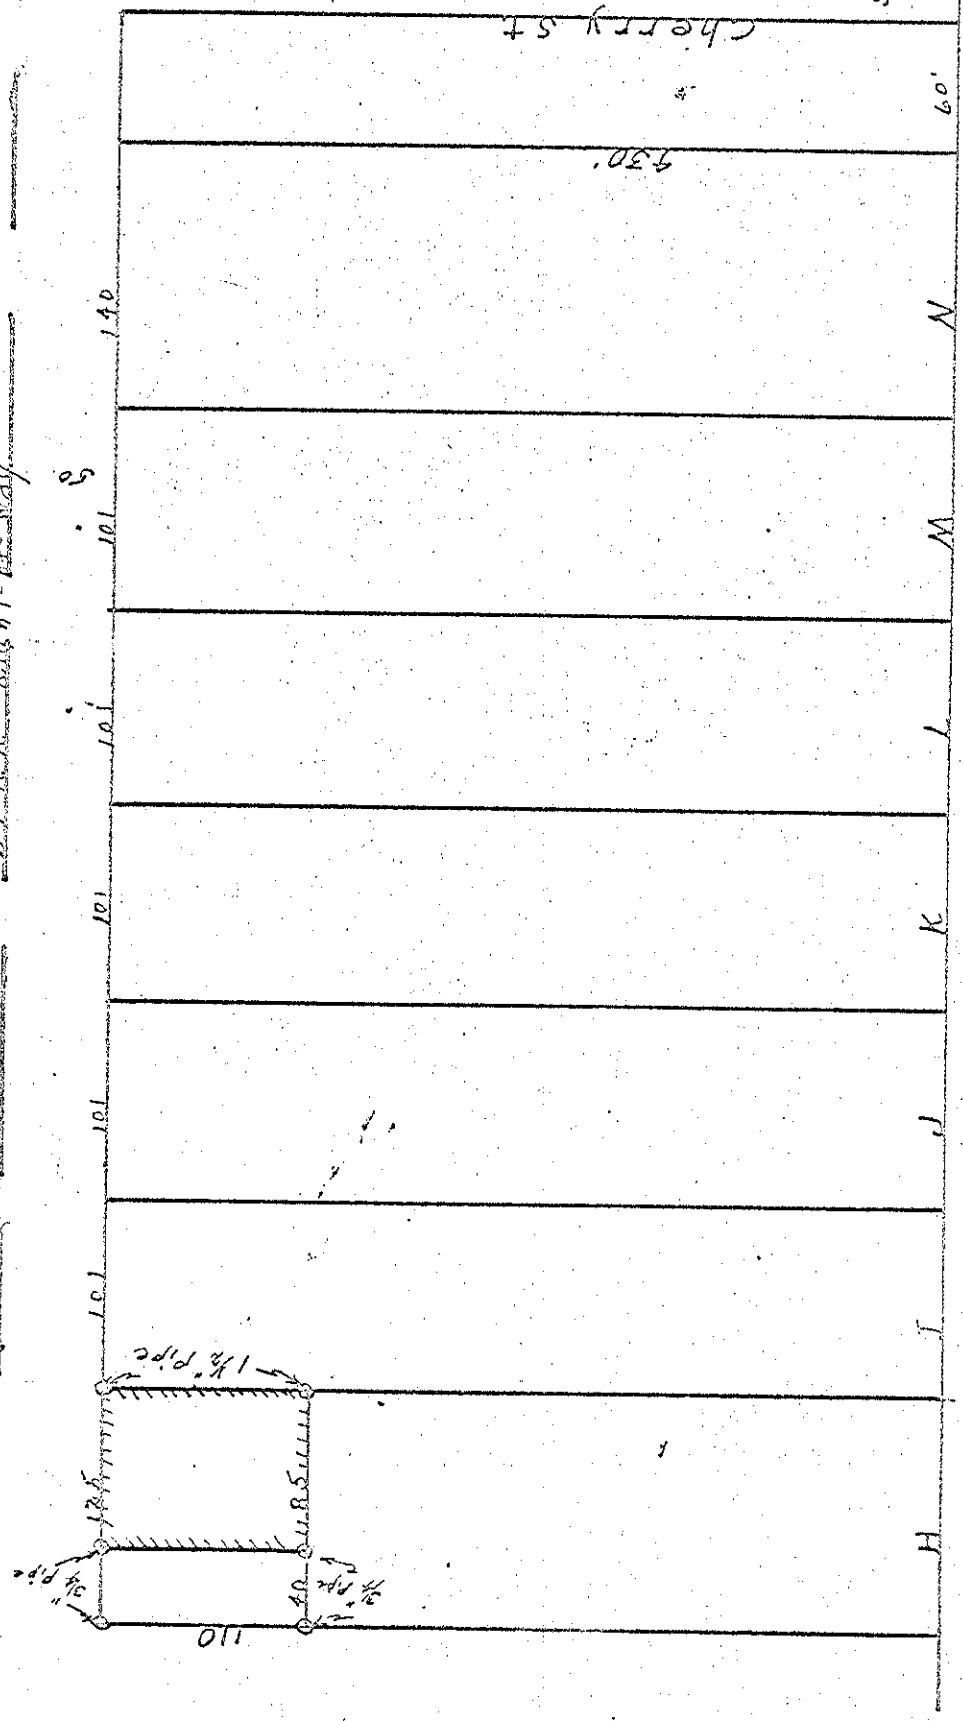

I certify this survey completed by me in Dec. 1959.
 That portion in N.E. Cor of lot 'H' in Coggans Second
 Addition to La Grande, Oregon

Adams Ave

REGISTERED
 COURSE ON
 LAND SURVEYOR
 MAY 3, 1956
 JAMES G. VOELDT
 507