811

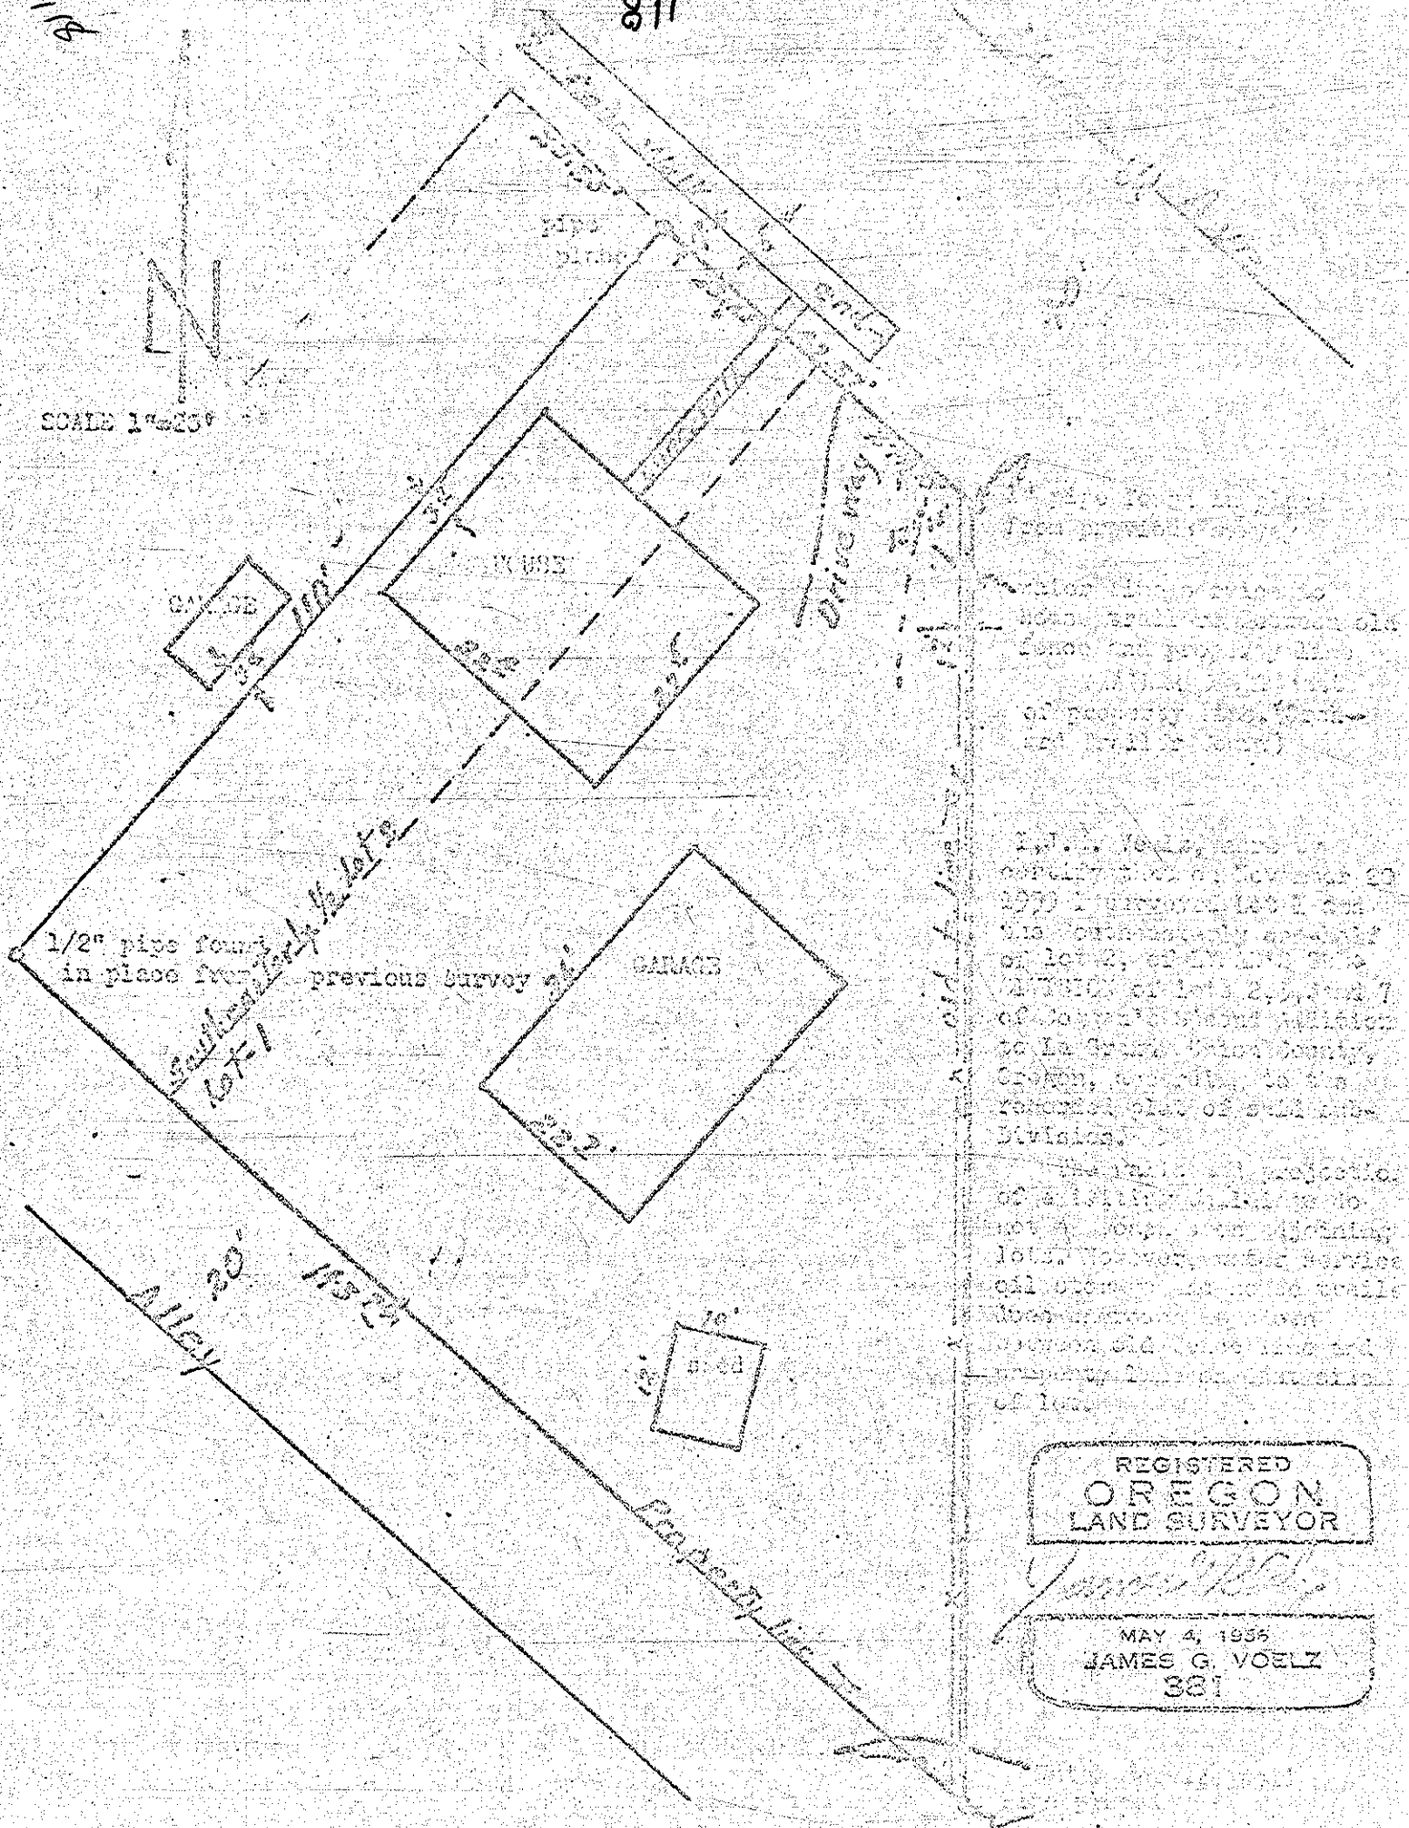

REGISTERED
OREGON
LAND SURVEYOR

MAY 4, 1956
JAMES G. VOELZ
381