3S38DA

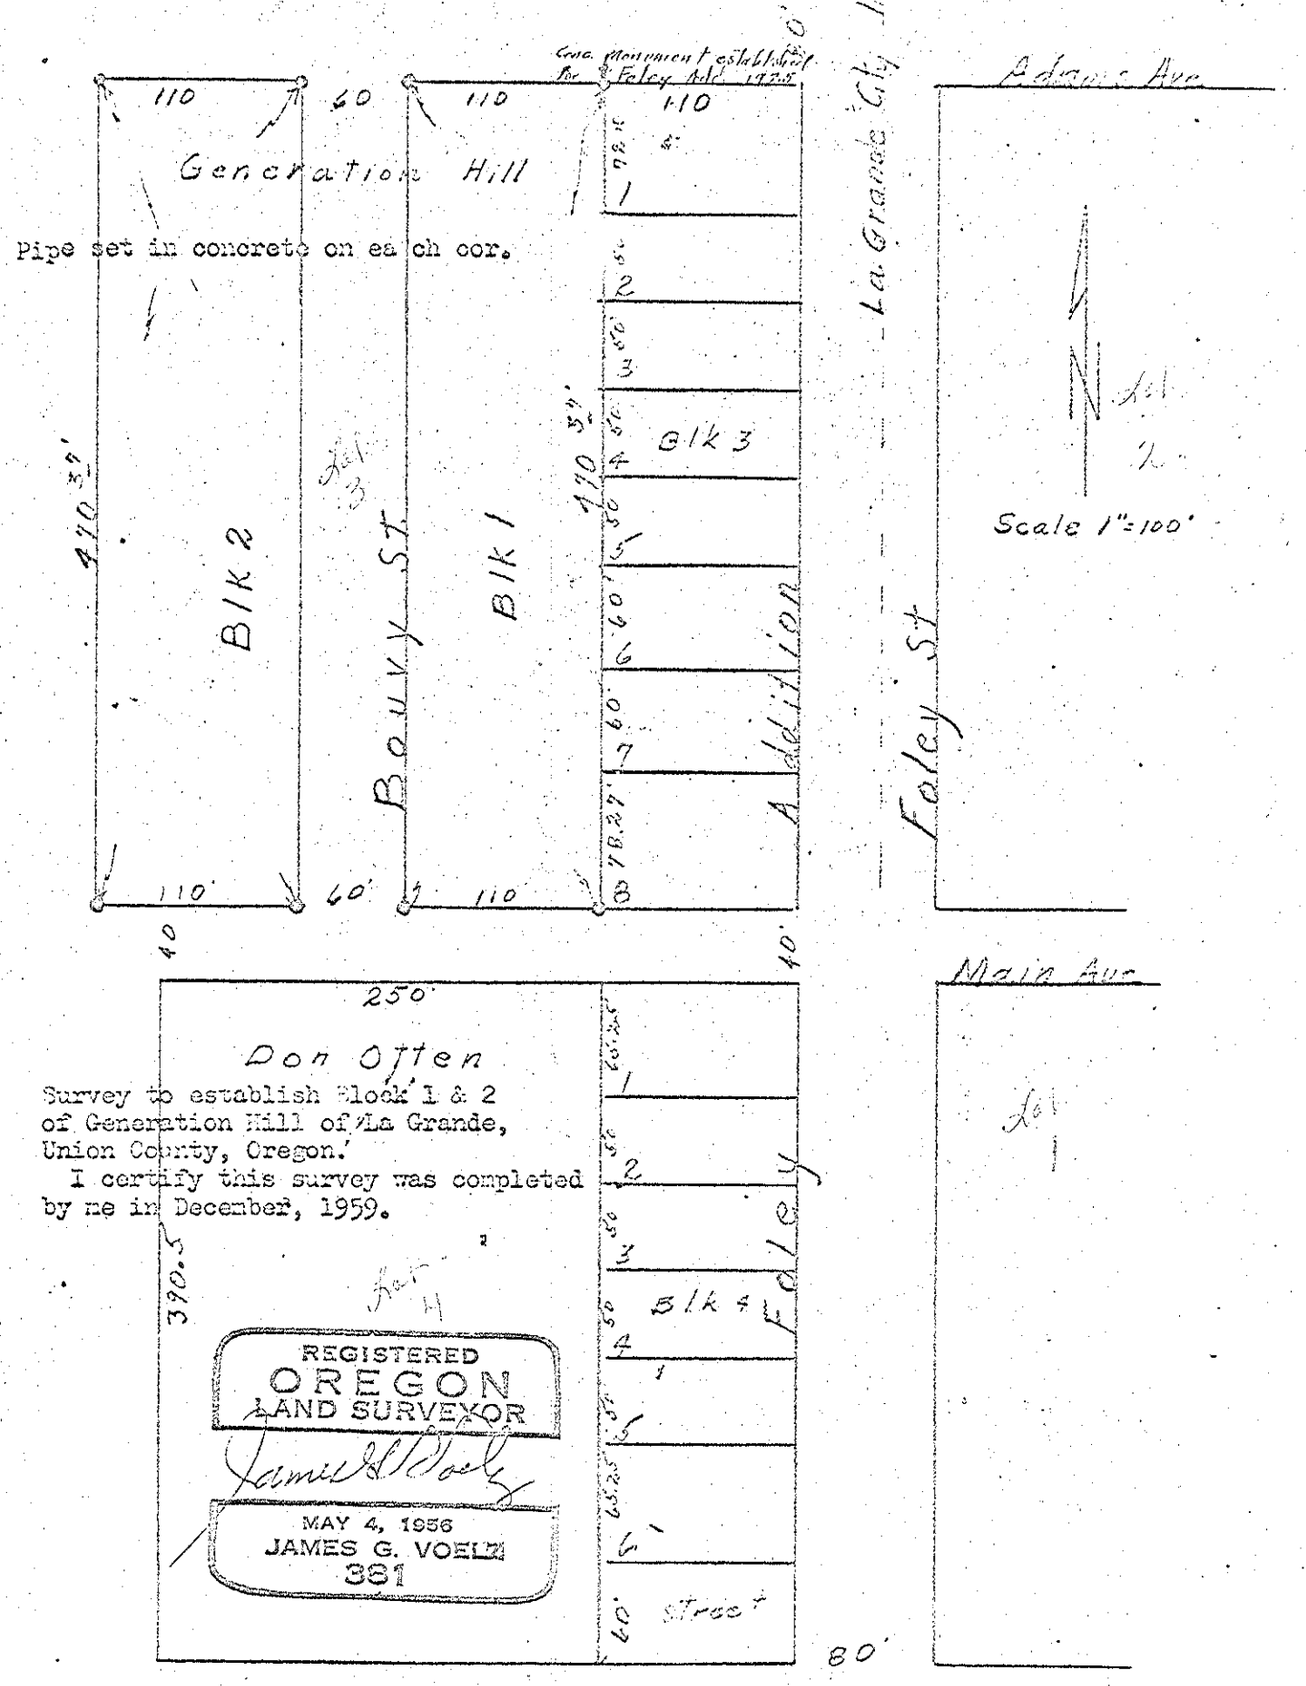
Conc. monument established for Foley Add 1925
110
60
110
110
Generation Hill
Pipe set in concrete on each cor.
Adams Ave
La Grande City Limits
Blk 2
Blk 1
Bouvy St
Blk 3
Addition
Foley St
Scale 1"=100'
Lot 2
Lot 3
Lot 4
Lot 1
Main Ave
250'
Don Often
Survey to establish Block 1 & 2 of Generation Hill of La Grande, Union County, Oregon.
I certify this survey was completed by me in December, 1959.
REGISTERED
OREGON
LAND SURVEYOR
MAY 4, 1956
JAMES G. VOELZ
381
Blk 4
Foley
Street
40'
80'