C21

Survey of south 1/2 of lot 5 and lot 6 of Block 5 of Wisdom's Addition of La Grande, Oregon

I certify this survey was completed by me in Oct. 1959 and results are as shown.

REGISTERED
OREGON
LAND SURVEYOR
James G. Voelz
MAY 4, 1956
JAMES G. VOELZ
381

N
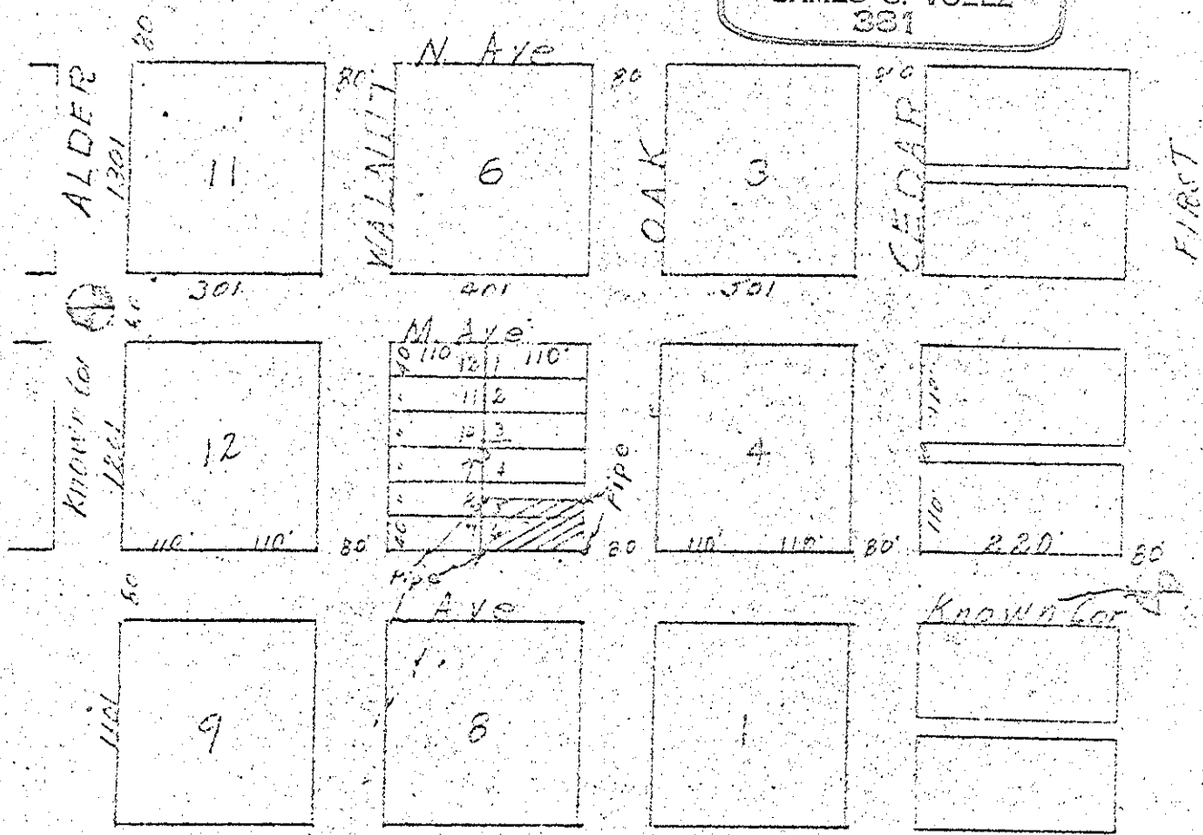
Scale 1" = 200'