

128
SAMES
128


128

SURVEY

OF

LOTS 7 & 8, BLOCK 18, CHAPLIN'S ADDITION
LA GRANDE, OREGON.

FOR LEE MCLAUGHLIN
8-8-54.

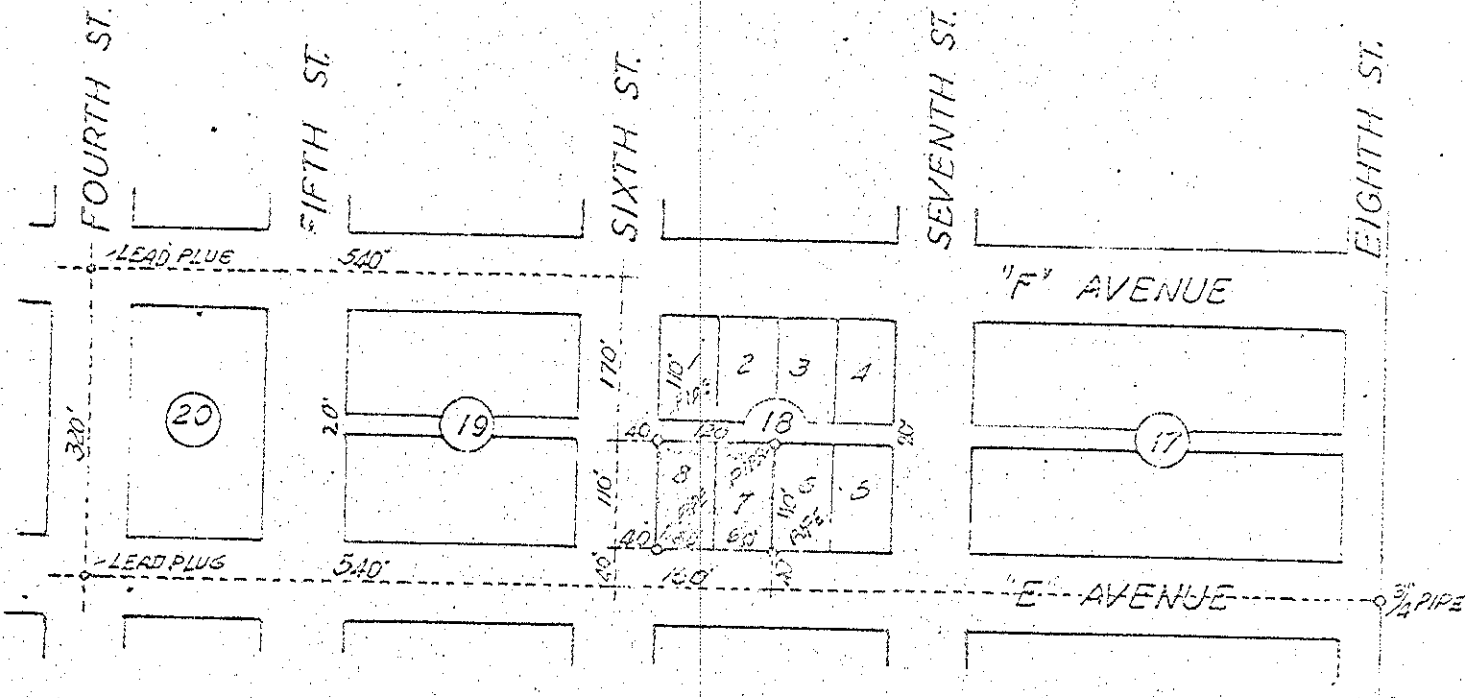

SCALE 1"=200'



128