

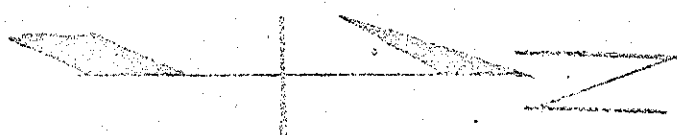


MONUMENT NORTH SPRUCE STREET

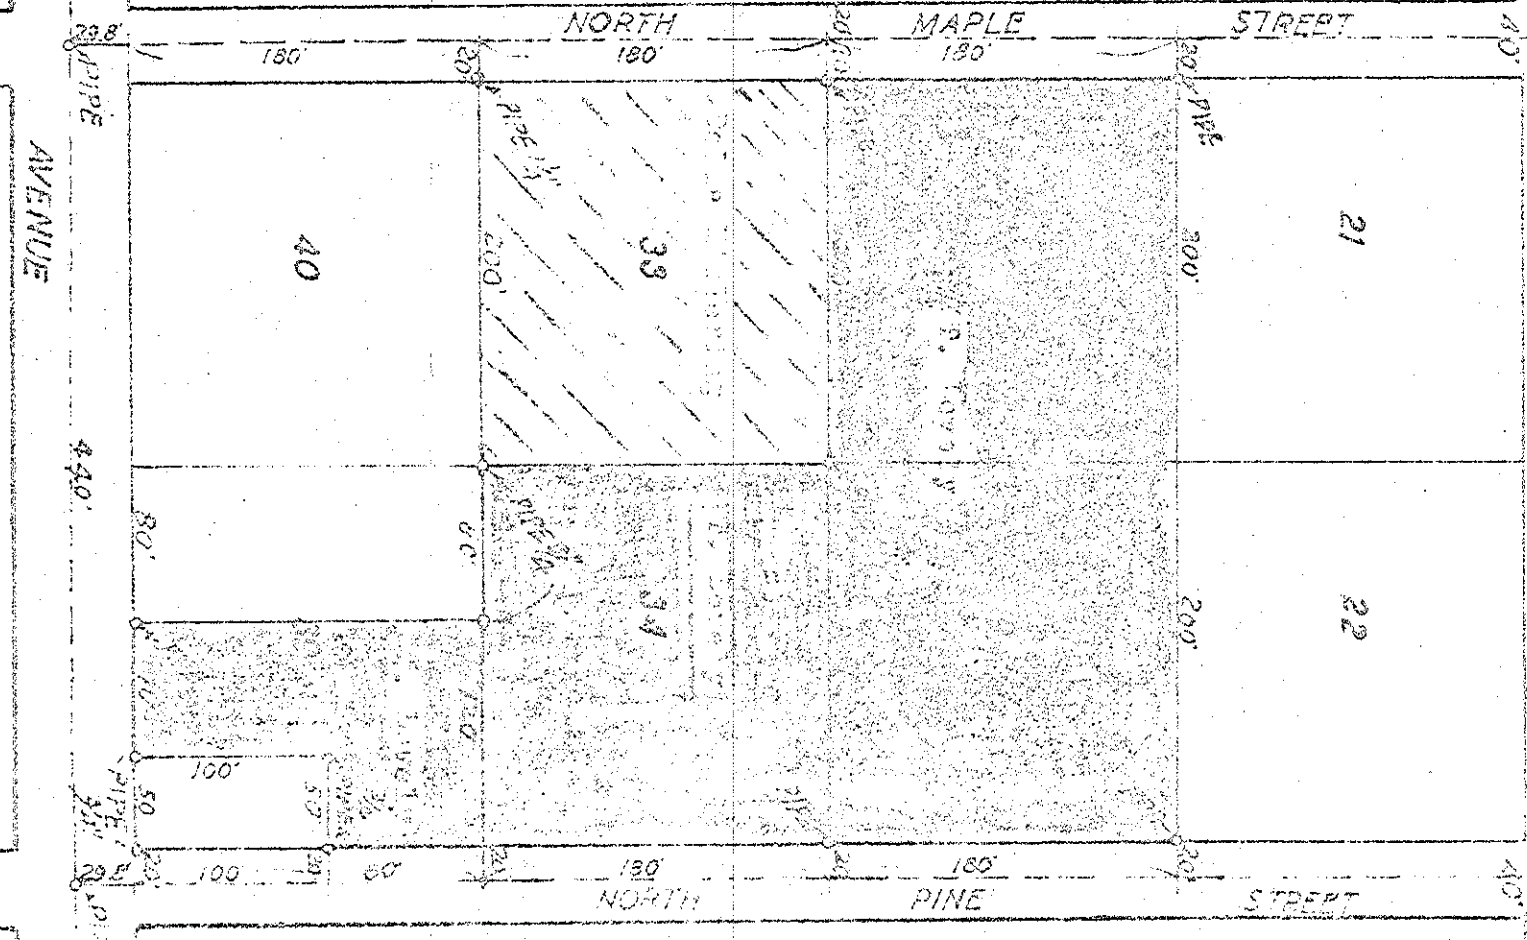

PLANNED AND DATA PREPARING
 APRIL 25, 1924.
 SOUTH 71-1001

RUSSELL

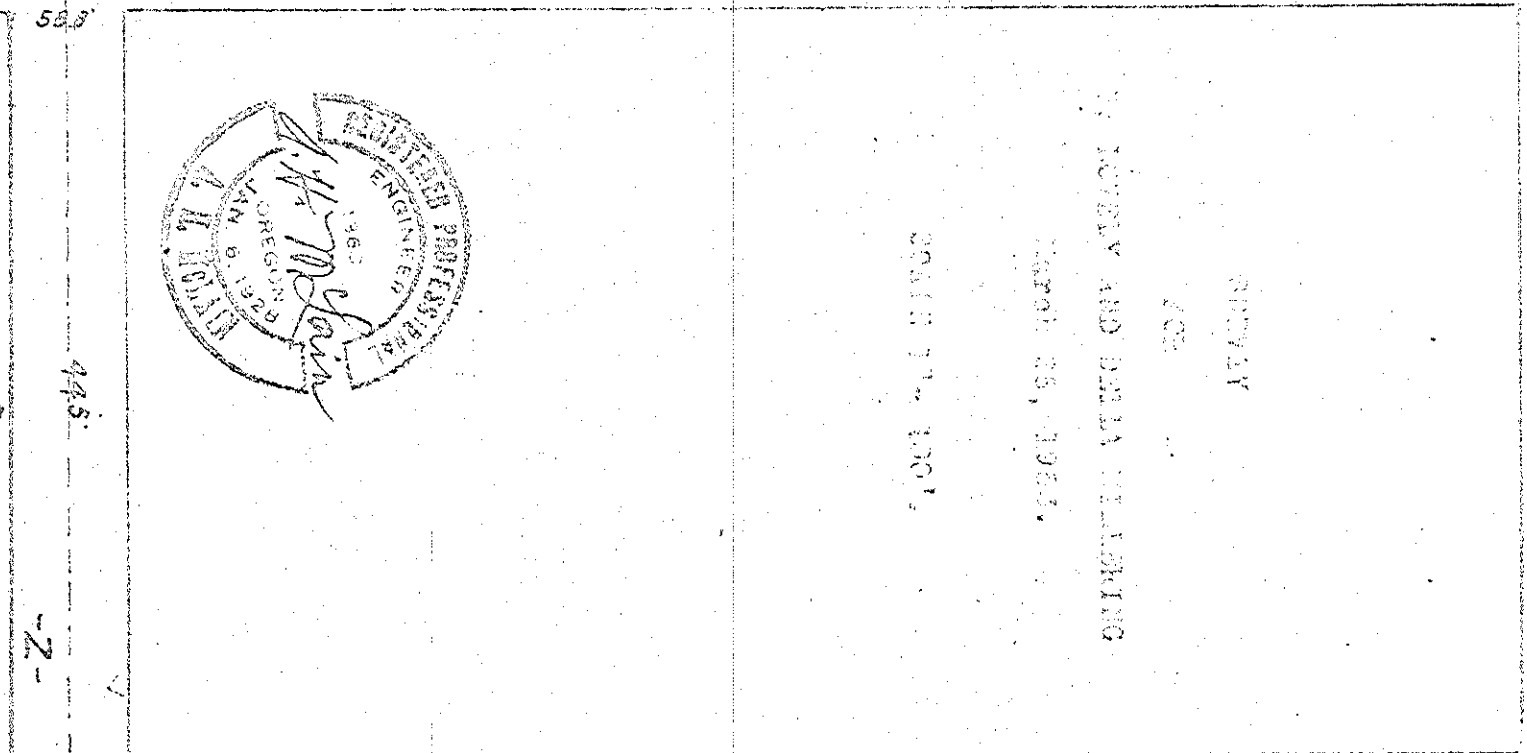

-2-