

143

116713
E. OF SECTION 6, T. 3 S. R. 38 E. W. 4


SCALE 1"=80'

SURVEY OF

Beg at a point 274' E. of NW cor of SE 1/4 section 6, T. 3 S. R. 38 E., said point being the NE cor of the Rumelhart property; thence E. 106'; thence S. along the W. line of Alder Street 476'; thence W. 106' to the SE cor of Rumelhart property; thence N. 476' to point of beg., excepting that part on the N. side used as street.

A.H.M.

June 19, 1950. For John Bernhardt.

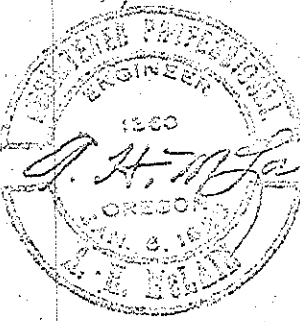

N. B. This survey is incorrect as to the description in deed. The tract was marked as requested by the grantor and grantee of the deed, and is 8.17 ft short on the West side and 5.1 ft short on the West side. The distance is on the south side of the tract. The N and W dimensions are correct the N and W do not conform to distances given in deed.

143