#148

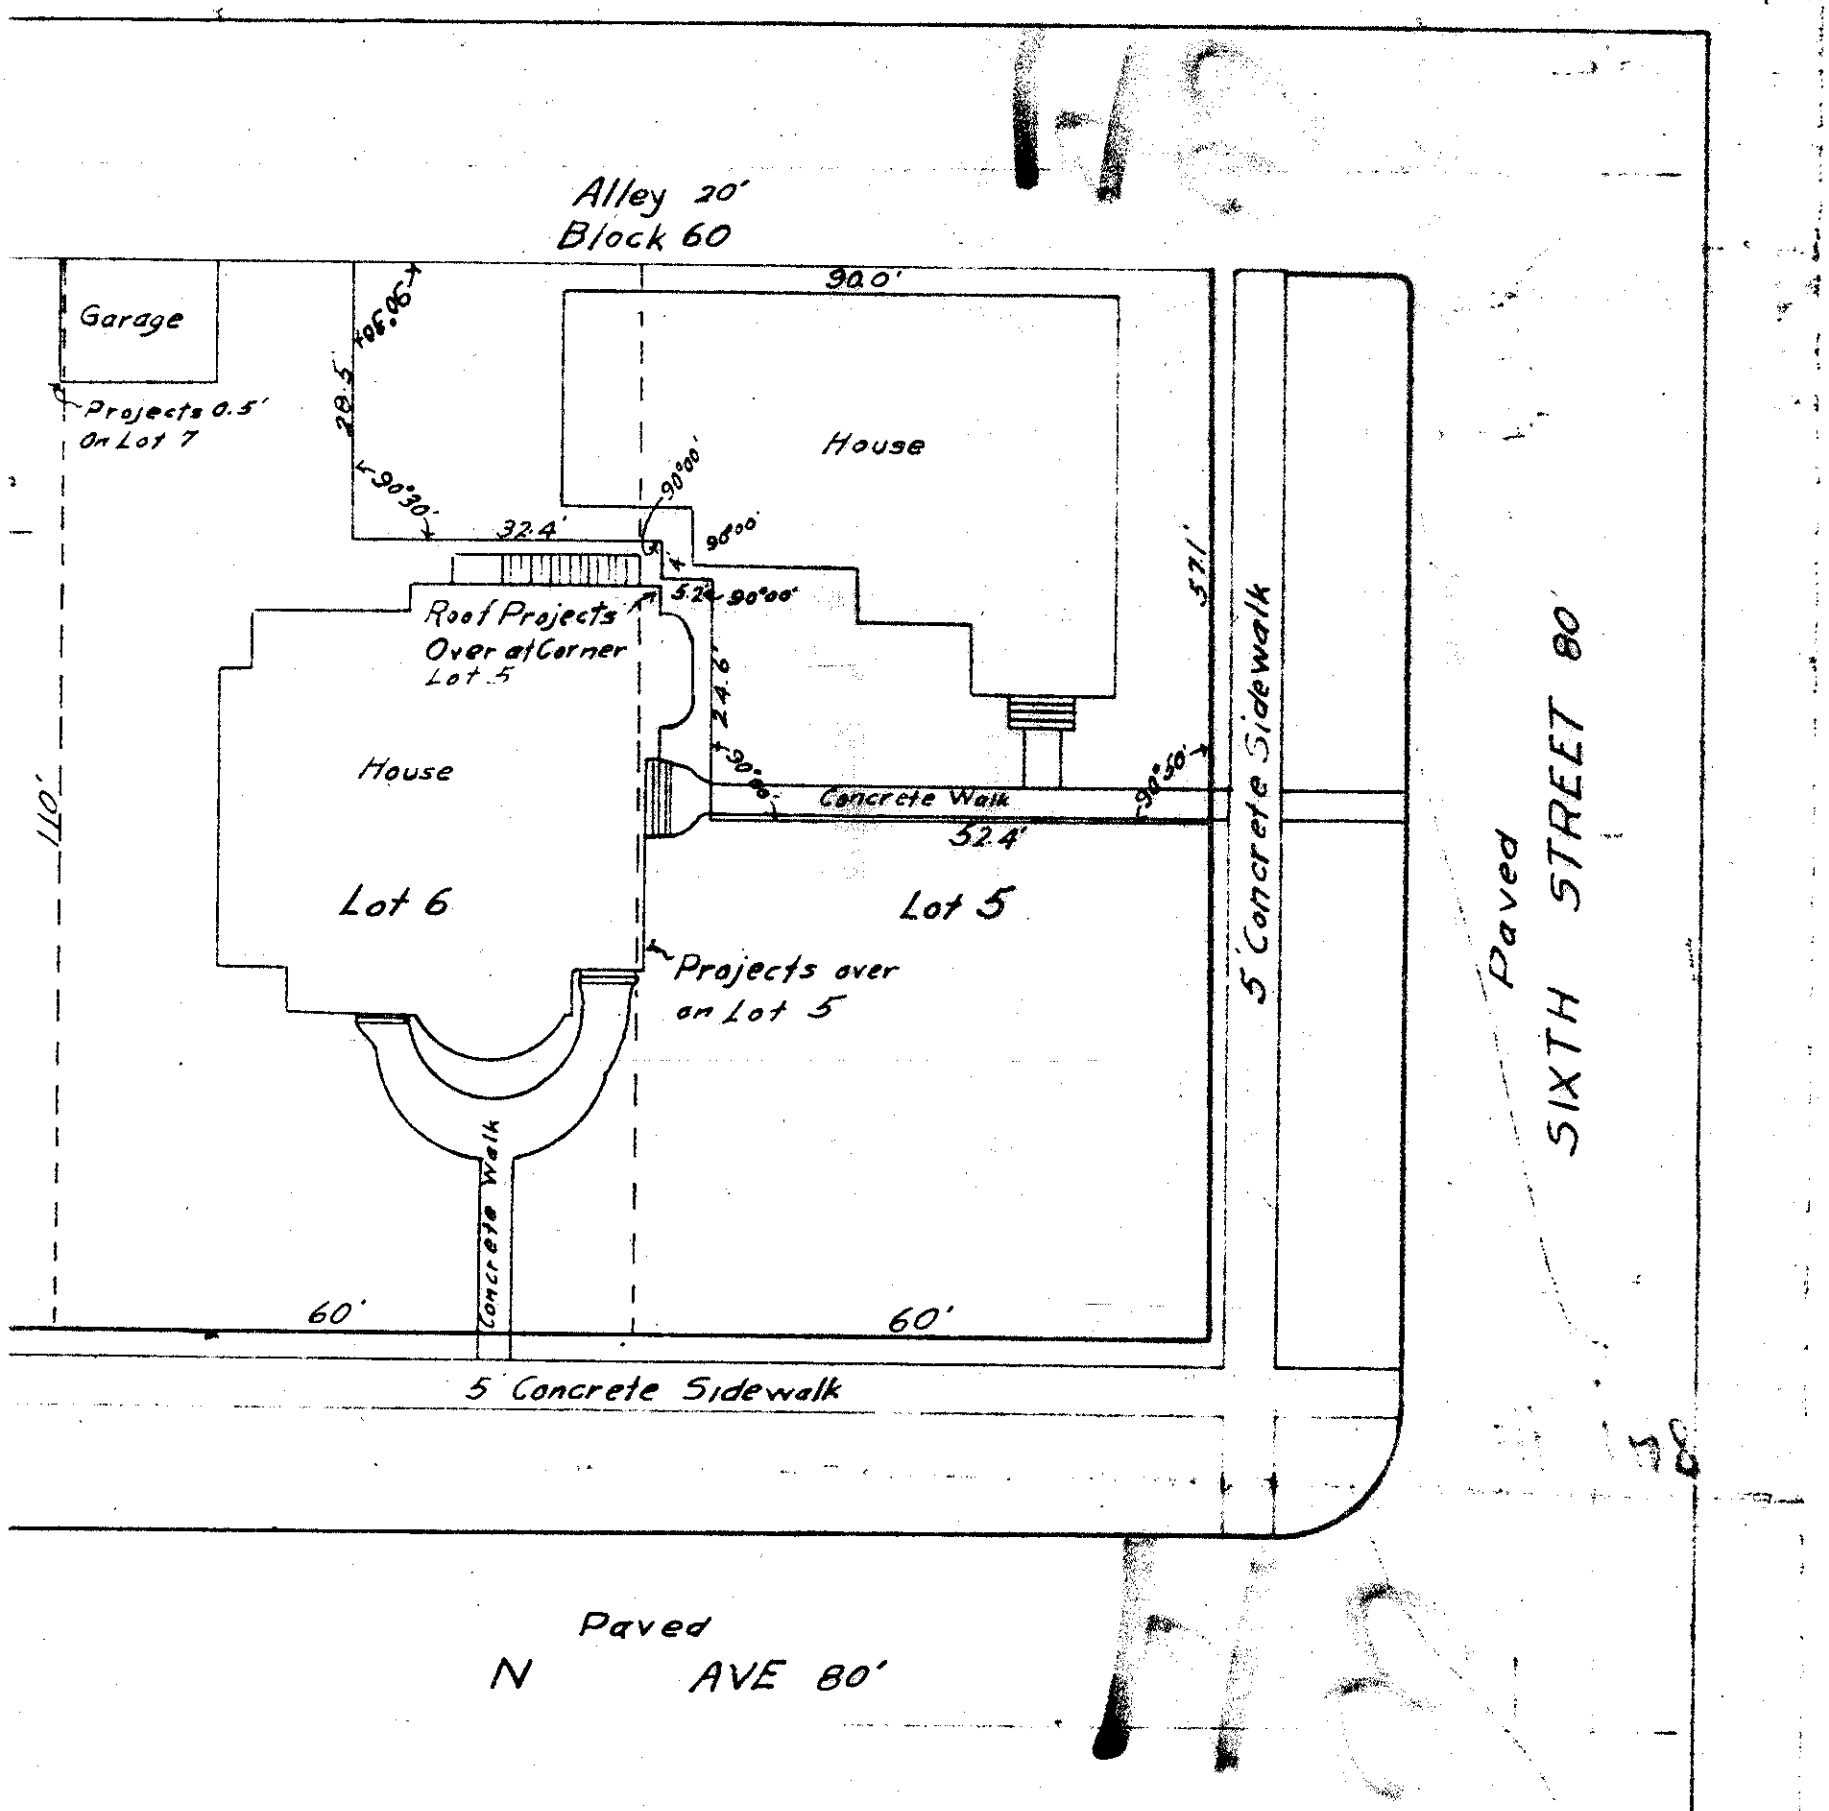

[illegible] last conform to the recorded plat thereof. [illegible] projections of the buildings on said lots [illegible] the streets, neither do the walls and projections [illegible] attempt to show [illegible] map. [illegible] position of the adjoining buildings do not [illegible].

[illegible], 19[illegible]

S B Morgan
Civil Engineer
La Grande, Ore.

S B Morgan

148

BLK 60
CHAPLIN'S