


House

Survey for Deas Knight
1003 Twelfth St.
La Grande, Oreg.


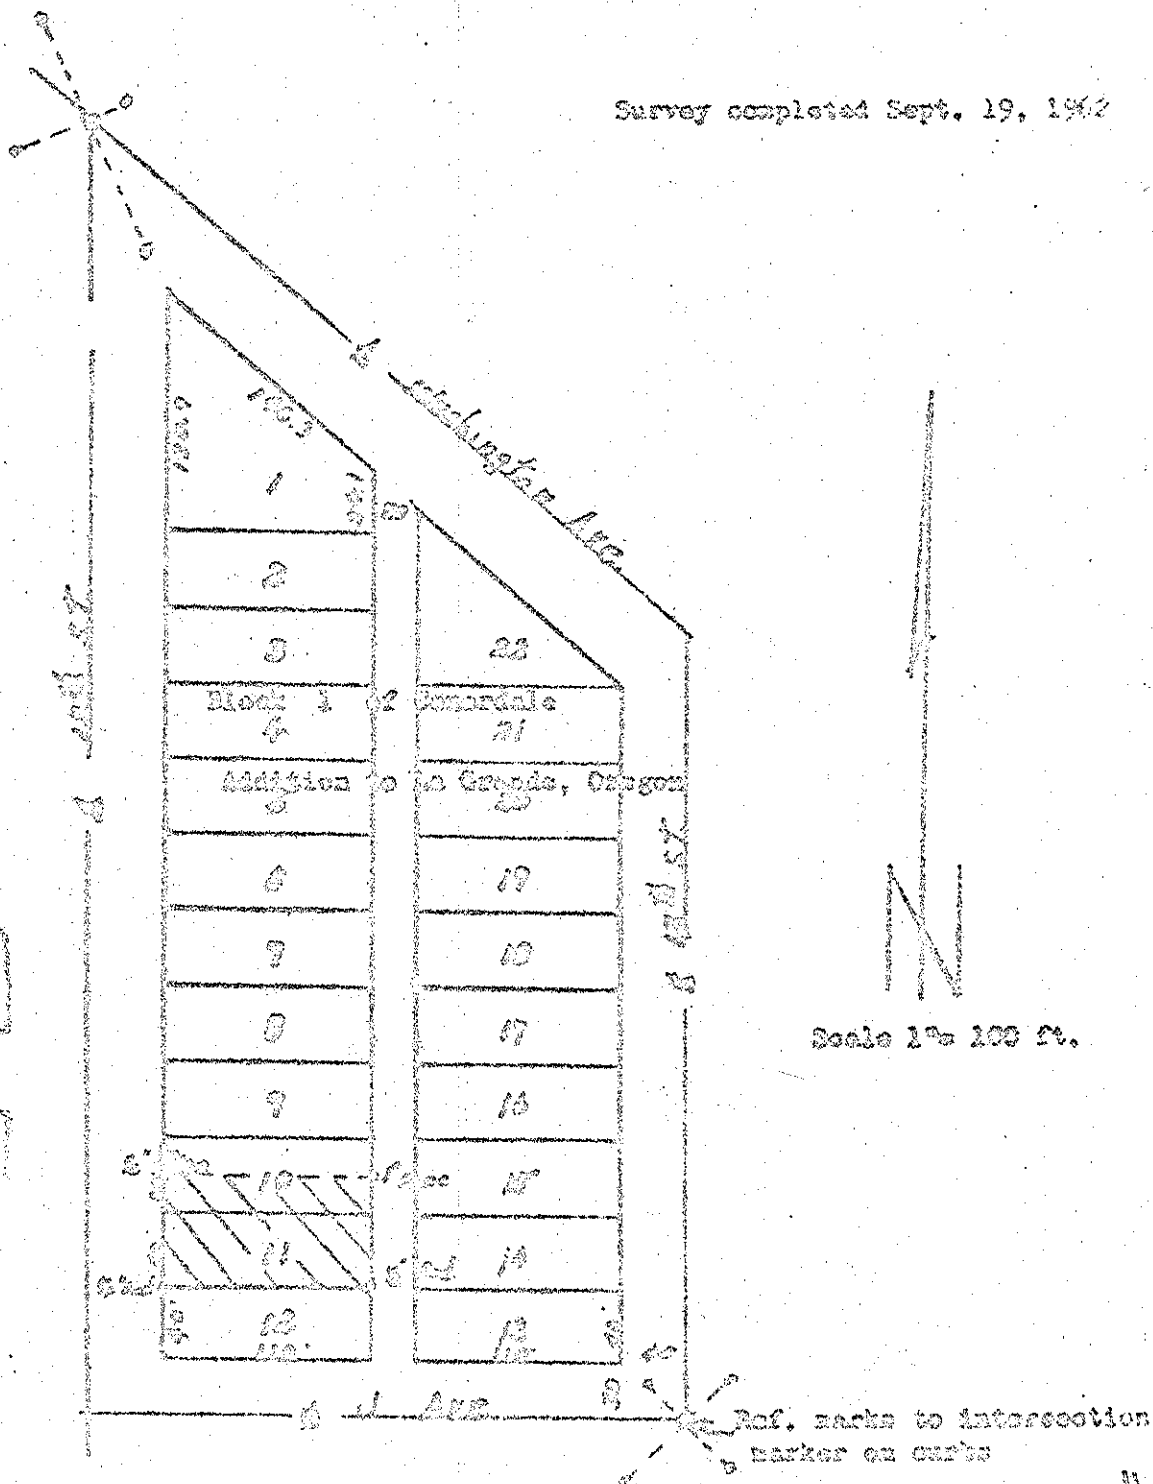

REGISTERED
 OREGON
 LAND SURVEYOR
James Bell
 1215 1/2

Hereby certify following part of Block one;
 La Grande, Union County, Oregon.

#154