

**UNION COUNTY  
SURVEYOR**

Date Received \_\_\_\_\_


Date Filed 3-3-84

By G. LANGLITZ, DEPUTY

File No. NARRATIVE 1/4

SURNEY No. 160

MAIN STREET

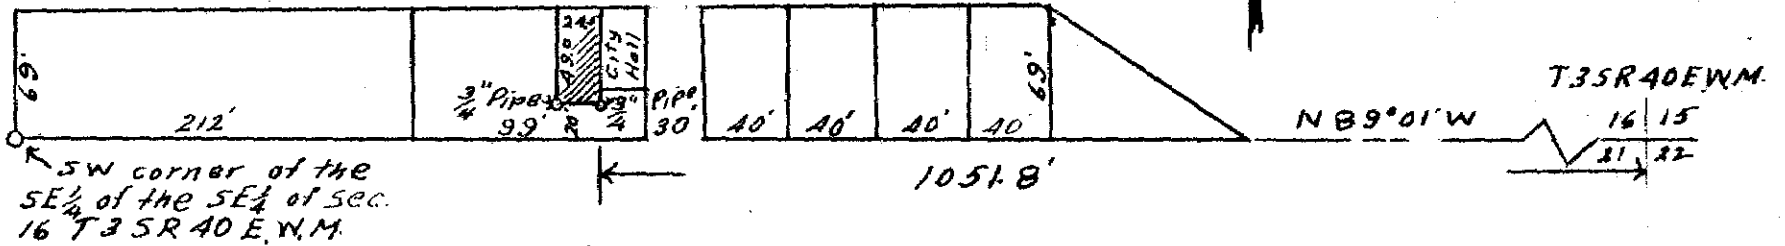

Property of  
West Coast Telephone Company  
In Cove Oregon  
Sept. 8, 1952 Scale 1 in. = 100 ft.

SURNEY 160

SURNEY 160

**SURVEYOR**


Date Received \_\_\_\_\_

Date Filed 3-3-86

By \_\_\_\_\_

File No. NARRATIVE 1/4

SEE SURVEY 160

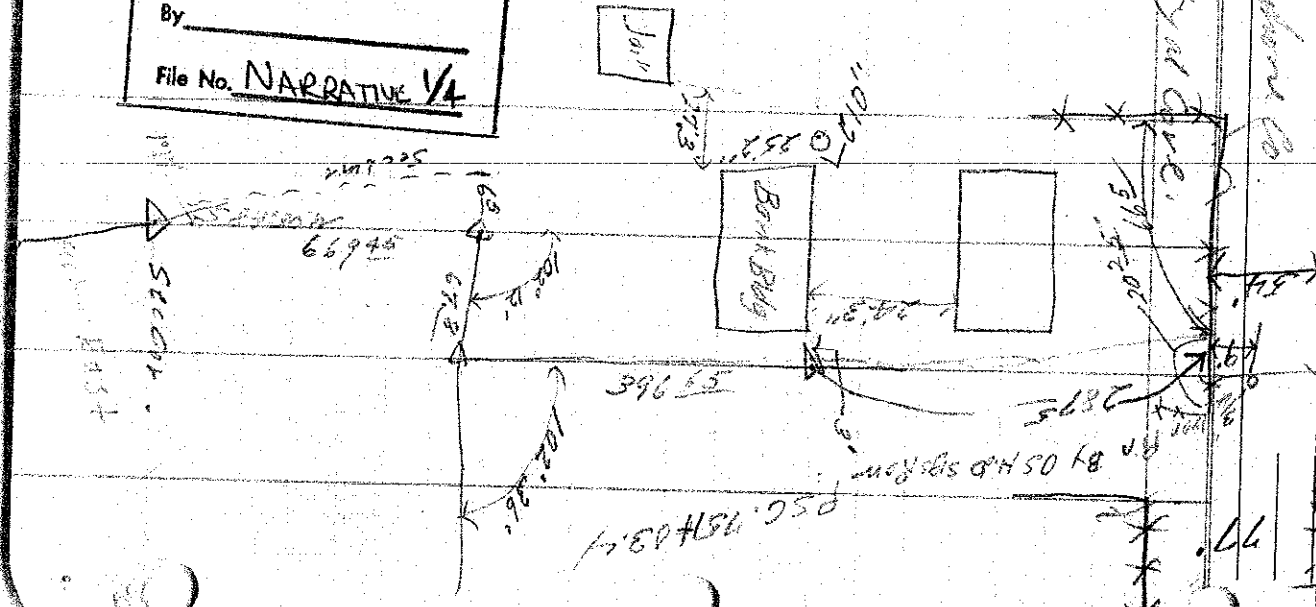

Project Hudson Co

LINE DATE

PARTY

77.66

$$\begin{array}{r} 77 \\ 12 \\ \hline 156 \\ 192 \\ \hline 348 \end{array}$$


$$\begin{array}{r} 2.31 \\ 61 \\ \hline 13960 \end{array}$$

$$\begin{array}{r} 85 \\ 20 \\ \hline 51 \end{array}$$

$$\begin{array}{r} 1.6 \\ 86 \\ \hline 1339 \end{array}$$

$$\begin{array}{r} 1460 \\ 8460 \\ \hline 9920 \end{array}$$

$$\begin{array}{r} 040 \\ 25 \\ \hline 0315 \end{array}$$

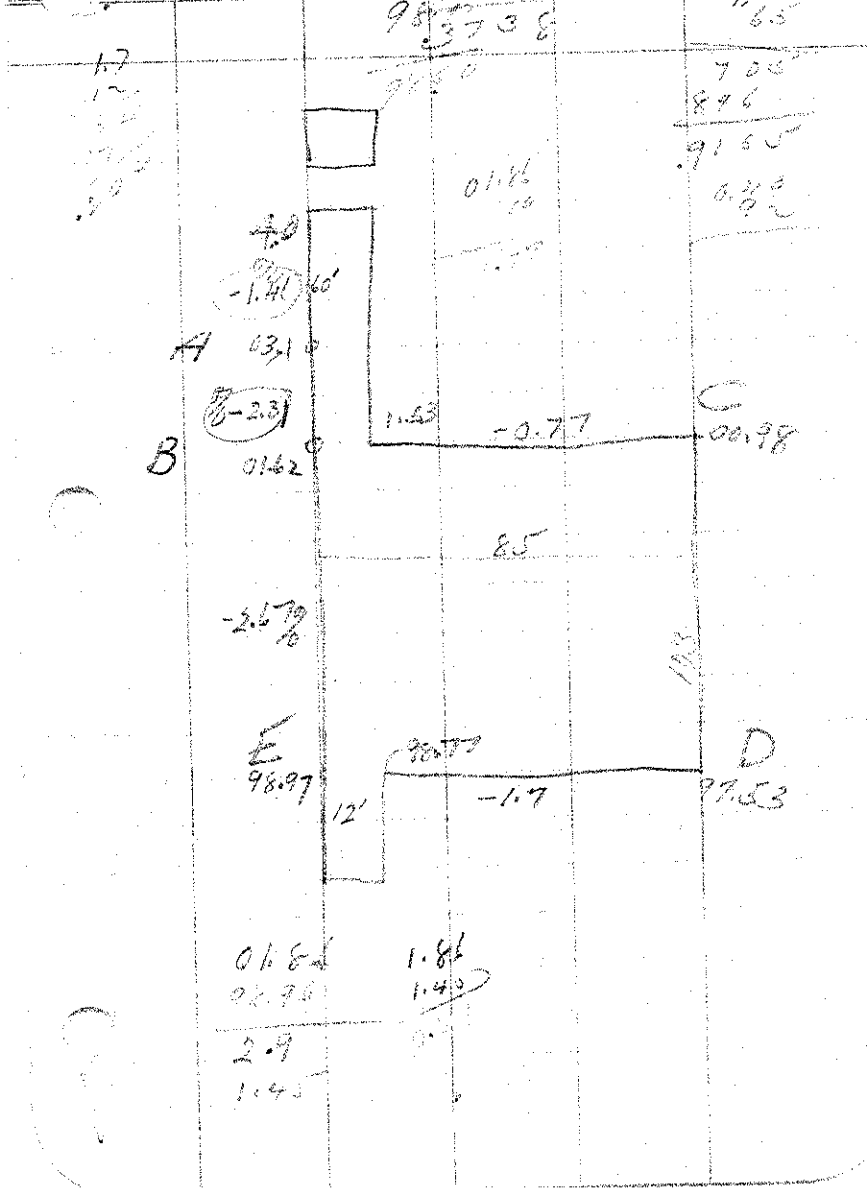

West Coast Telephone Co

Commencing at the N.W. cor of the  
land owned by Core State Bank in the  
City of Core. The run is thence W  
 $24\frac{1}{2}$  ft. thence S 49 ft. thence east  
 $24\frac{1}{2}$  ft. thence N to the by.

322 - B128

Com. 12 rods 14 ft E of SW 00L  
E  $\frac{1}{2}$  SE  $\frac{1}{4}$  Sec 16 T 35 R 40  
thence E  $49\frac{1}{2}$  ft N 100 ft W  $49\frac{1}{2}$  ft  
S 100 ft to by.

145  
12  

---

330  
65  

---

1980  

---


212

<b>UNION COUNTY SURVEYOR</b>	
Date Received	_____
Date Filed	3-38-85
By	_____
File No.	NARRATIVE 14

SEE SURVEY 160

S. B. Morgan

311  
276

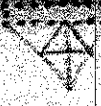

Cove Lot

286  
24 1/2

Commencing at a point on the south line of the county road 286 feet east and approximately 100 feet north of the southwest corner of the southeast quarter of southeast quarter of section 16, in township 3 south, range 40 east of the Willamette Meridian, said point of beginning being the northwest corner of Cove State Bank property (deed book 59, page 180); and running thence south 49 feet; thence west 24 1/2 feet; thence north 49 feet to the south line of said road; thence east 24 1/2 feet to the place of beginning;

**UNION COUNTY  
SURVEYOR**

Date Received \_\_\_\_\_

Date Filed \_\_\_\_\_

By \_\_\_\_\_

File No. NARRATIVE 1/4

SEE SURVEY 160