4—672b

UNION COUNTY SURVEYOR

Date Received _____

Date Filed 3-3-86

By G. LANGLITZ, DEPUTY

File No. No 161

SEE NARRATIVE DRAWER 1/4

FIELD NOTES

of

Sections 17, 18, and 19, T. 1 N., R. 40 E.,
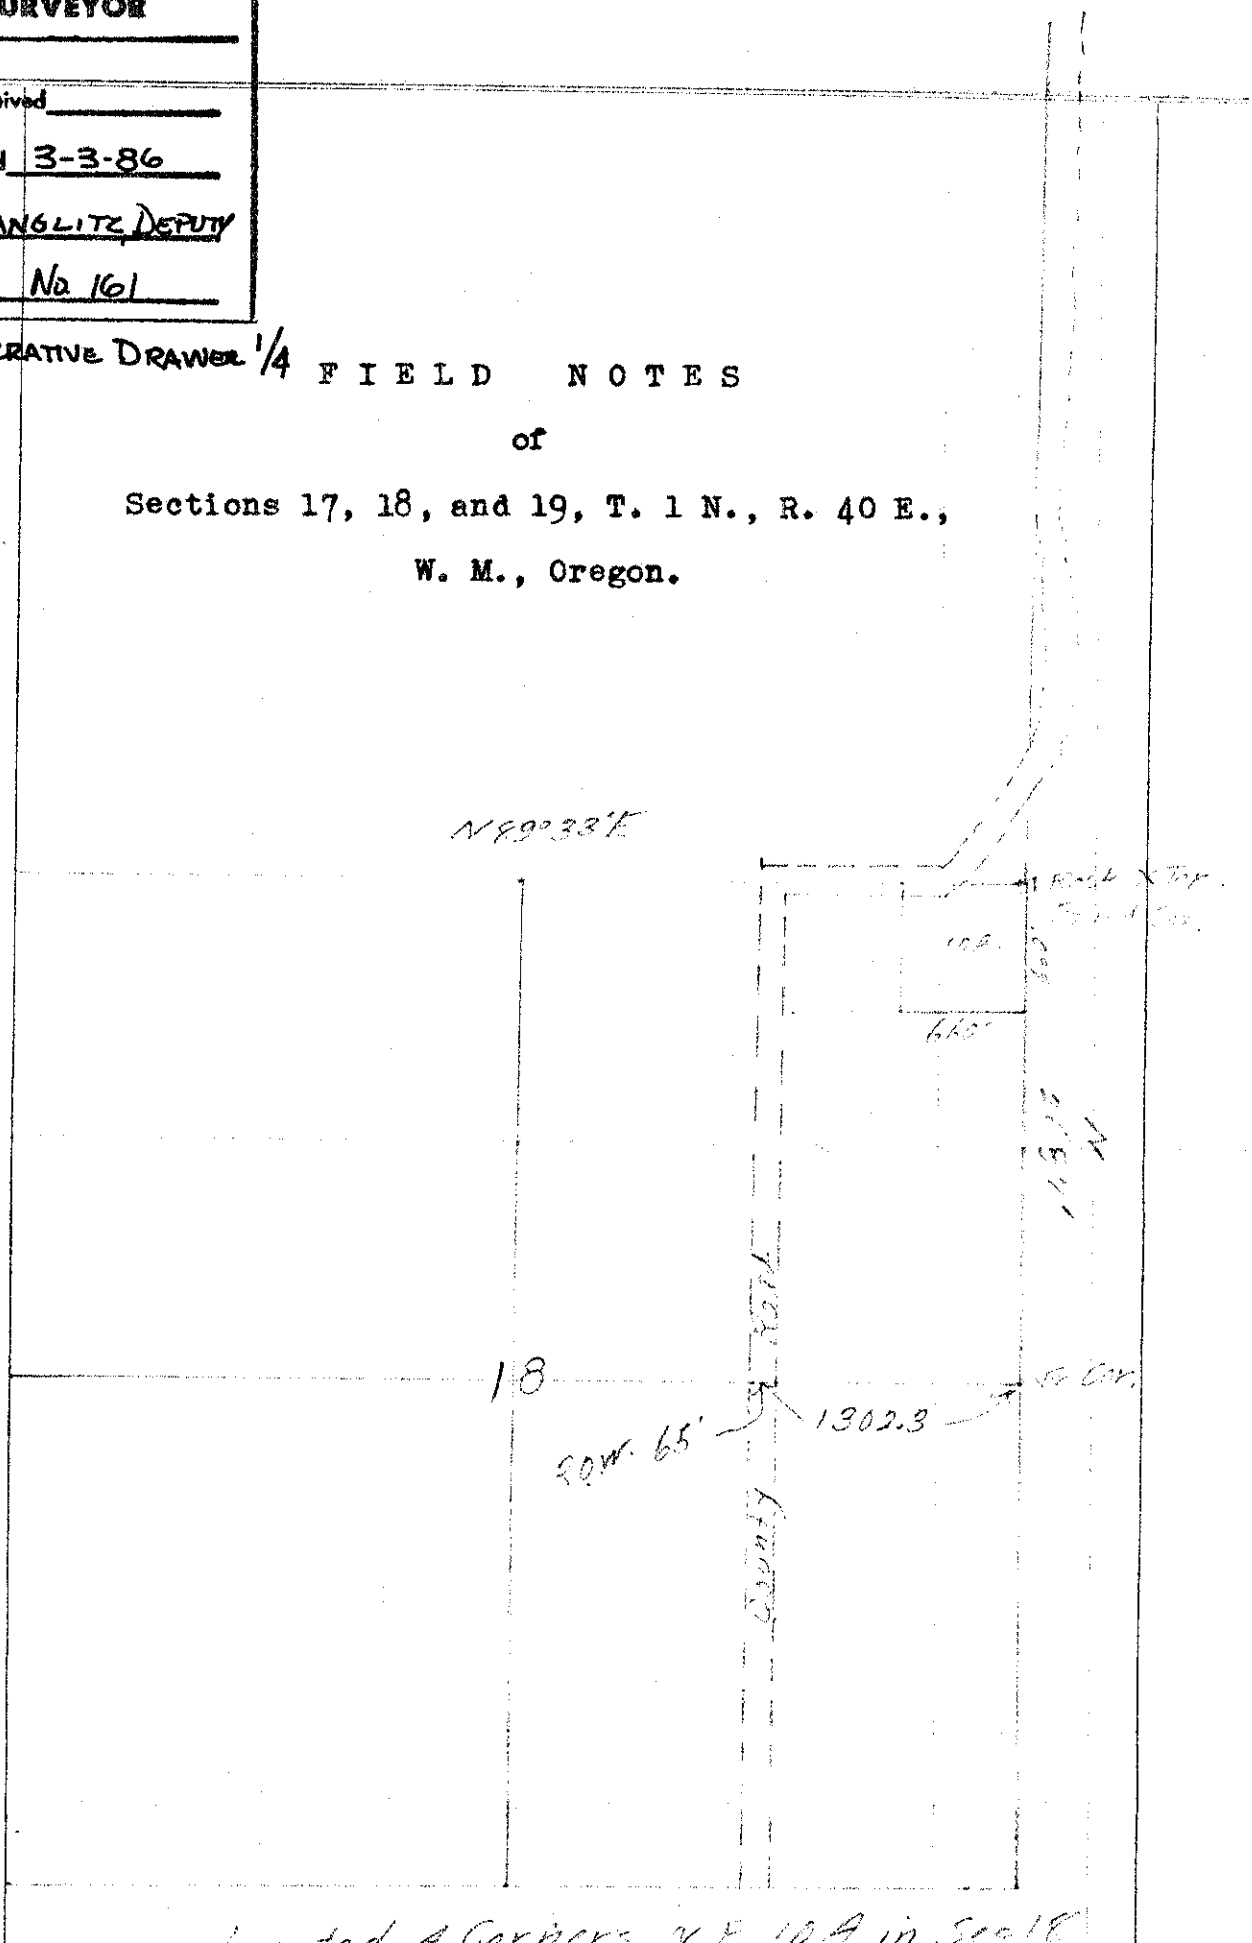
W. M., Oregon.