

T15R38EWM

2-1

1



NE 1/4 of SW 1/4
39.1 A.

SE 1/4 of SW 1/4
38.2 A.

County Road

Pipe Line 1
Pump Stations
Pipe Line 2

N44°46'E 9392'
N53°05'E 8002'

36" Pipes

County Road

2

11 12

2

12

Scale 1 in. = 300 ft.

60




I, S. B. Morgan of La Grande, Oregon do hereby certify that this map was made from notes taken during an actual survey made by me on August 14, 1949; that the monuments shown on this map consisting of two 1 1/2" Pipes 36" long are N53°05'E 8002 ft & N44°46'E 9392 ft. from the section corner common to sections 1, 2, 11 & 12 T15R30EWM.

S.B. Morgan

T15R30EWM

2 1

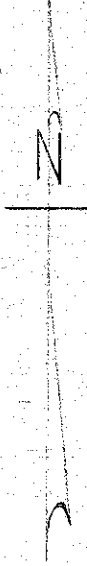

UNION COUNTY SURVEYOR	
Date Received	_____
Date Filed	3-3-86
By	_____
File No.	NARRATIVE 1/5

SEE SURVEY 163

NE 1/4 of SW 1/4


SE 1/4 of SW 1/4

County Road

1

12

60'

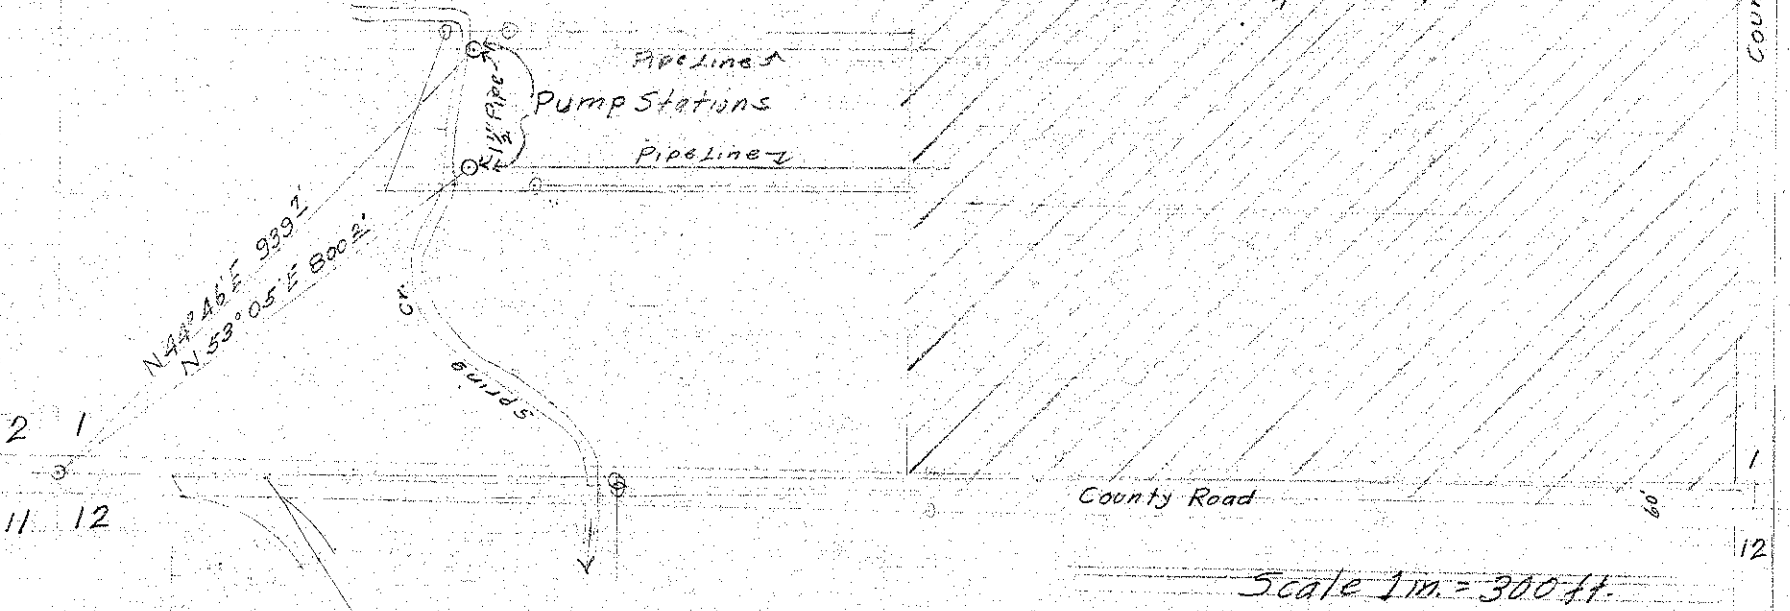

I, J. B. Morgan of La Grande, Oregon do hereby certify that this map was made from notes taken during an actual survey made by me on August 14, 1949, that the monuments shown on this map consisting of two 1 1/2" Pipes 36" long are N53°05'E 800.2 ft & N44°46'E 939.2 ft from the section corner common to sections 1, 2, 11 & 12 T15R30EWM.

J. B. Morgan

2 1
11 12

1000 E

**UNION COUNTY
SURVEYOR**

Date Received _____

Date Filed 3-3-86

By _____

File No. NARRATIVE 45

SEE SURVEY 163

LINE DATE

PARTY

PROJECT

SHANNON 4194

Var 21° E

Start Loc	255	5.00	7.45	A.90	490.96
-1°	3.37	5.00	6.63	326	326.96
Eq. 42'S	2.65	5.00	7.35		470.96
Eq. N	3.85	5.00	6.15		230.96

