

32 | 33
5 | 4
T2SR38EWM
T3SR38EWM
N89°28'E
1306'

**UNION COUNTY
SURVEYOR**


Date Received _____

Date Filed 3-4-86

By _____

File No. # 165

SEE NARRATIVE DRAWER Y5

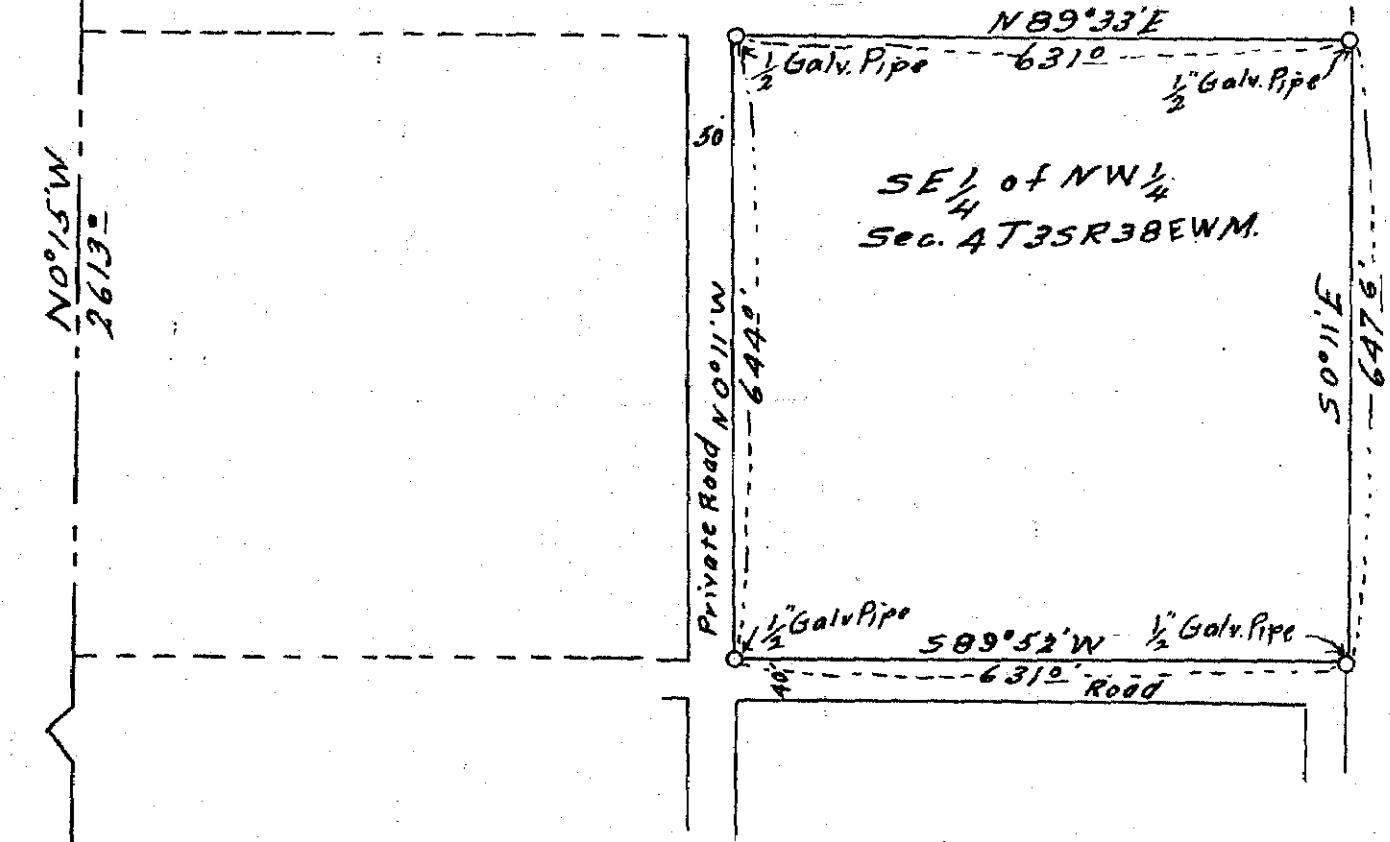

All that part of the property located in the S.E. 1/4 of N.W. 1/4 of Section 4 T 3 S.R. 38 E.W.M. and being more particularly described as follows;

Beginning at a point 649.5 feet South and 673.3 feet East of the Section corner common to Sections 4 & 5 T 3 S.R. 38 E.W.M. and Sections 32 & 33 T 2 S.R. 38 E.W.M., thence N 89°33'E a distance of 631.0 feet, thence S 0°11'E a distance of 647.6 feet, thence S 89°52'W a distance of 631.0 feet, thence N 0°11'W a distance of 644.0 feet, to the point of beginning.

Scale 1 inch = 20 feet.
Date Sept. 1, 1947

SURVEY No. 165

5 0 post
4
N0°15'W
2638.2'
5 0 A
8 9 Stone

32
5
Sec 5
Cor.
Lat 331406
Dep 7426E

N 89° 28' E
1305.9E

Lat 266459
Dep 1415.9E
1/2" Pipe

649.475 of Sec. 5
Common to Sec.
A 45 T 3 S R 30 E W M
32 933 T 2 S R 30 E W M

N 89° 33' E
631.2

656.7

Lat 266916
Dep 2046.3E
1/2" Pipe

N 0° 11' W
644.2

1293.425 of Sec. 5
Common to Sec.
A 45 T 3 S R 30 E W M
32 933 T 2 S R 30 E W M

S 89° 52' W
631.2

S 0° 11' E
647.6

Lat 202311
Dep 2046.3E
1/2" Pipe

N 0° 15' W
2613.2

Lat 202311
Dep 1417.9E

656.7

5
4
Sec 5
Cor.
Lat 70114
Dep 73115E

923 1/2 from center to RR Track

2638.2

UNION COUNTY SURVEYOR	
Date Received	_____
Date Filed	3-4-86
By	_____
File No.	NARRATIVE 1/5

SEE SURVEY 165

RR Track

5
8
9
Sec 5
Cor.

Oregon State Highway Commission

TRAVERSE SHEET

City _____ Section _____ Calculated by _____
Highway _____ Line _____ Sheet No. _____ Checked by _____

STATE PRINTING DEPT.

STATION	CURVE DATA		Tan.	Sub. Tan.	P. I. to P. I.	Calculated Course	Cosine	Sine	LATITUDE		DEPARTURE		CO-ORDINATES	
	Degree	Angle							+N.	-S.	+E.	-W.	Lat.	Dep.
C						589°36'E								
D		0°57'L				49° N89°33'E	0078539	9999692	0 ³⁸		49°		266916	199792
O						6277 589°33'N	9999692	0078539		493	6277		266954	204692
P													26646	141922

**UNION COUNTY
SURVEYOR**

Date Received _____

Date Filed _____

By _____

File No. _____