


991 #

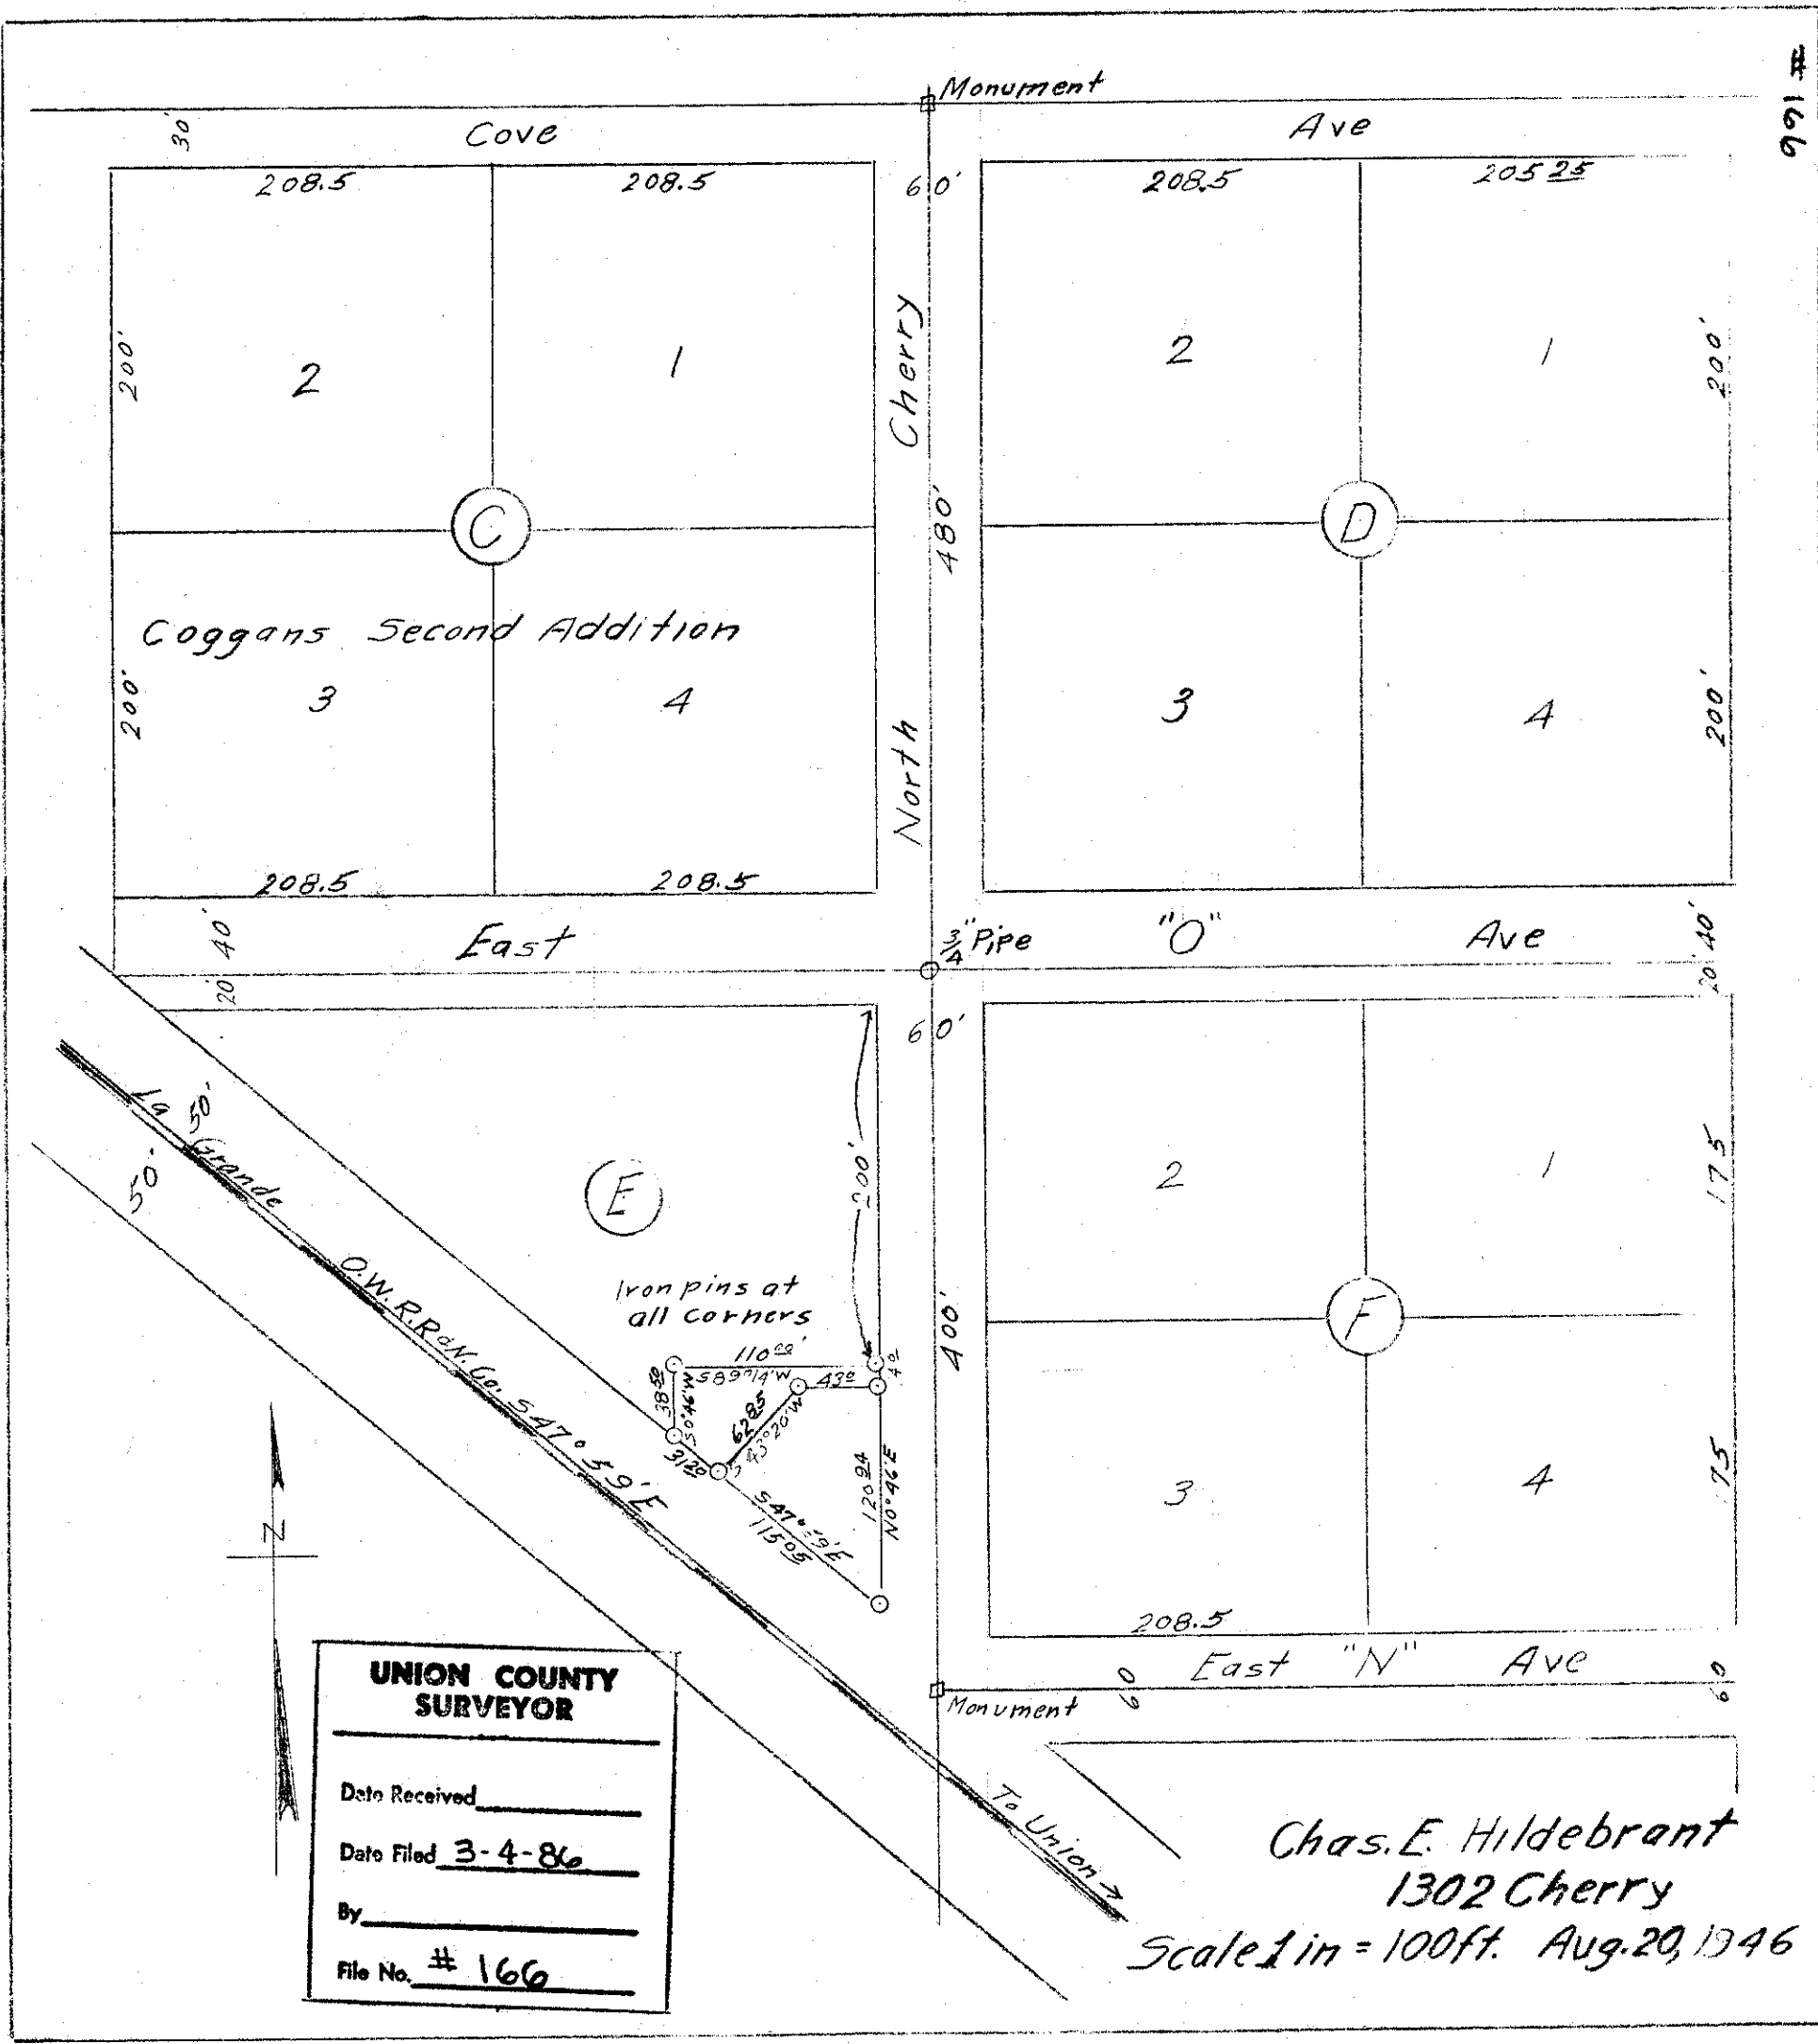

UNION COUNTY SURVEYOR

Date Received _____

Date Filed 3-4-86

By _____

File No. # 166

Chas. E. Hildebrant
 1302 Cherry
 Scale 1 in = 100 ft. Aug. 20, 1946

166