



Map of Block 67  
 La Grande, Oregon

Lake St

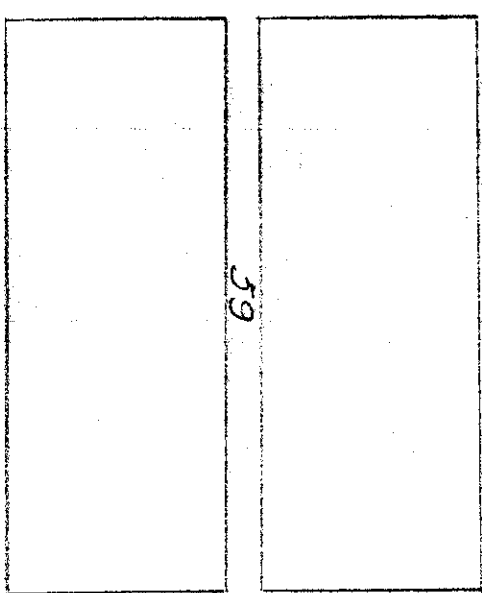

3/4" Pipe Found

3/4" Pipe Found

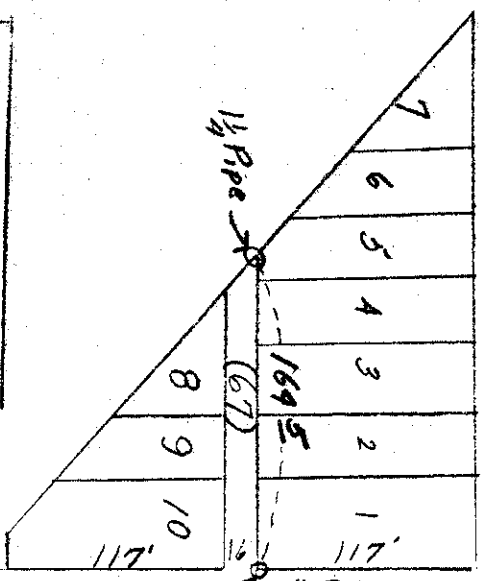

5-5736  
 Measure at  
 Found

**UNION COUNTY  
 SURVEYOR**

Date Received \_\_\_\_\_

Date Filed 3-4-86

By \_\_\_\_\_

File No. # 170

D. W. Eldridge  
 Set corners of Lot 145  
 Block 67 Riverside Addition  
 as shown.  
 Scale 1 in = 100 ft. June 29, 1948